


STATE OF KANSAS
STATE CORPORATION COMMISSION

ORIGINAL

WELL PLUGGING RECORD

Give All Information Completely
Make Required Affidavit
Mail or Deliver Report to
Conservation Division
State Corporation Comm.
245 North Water
Wichita, KS 67202

Clark County, Sec. 7 Twp. 35 S Rge. 25 E/W
Location as "NE/CNW 1/4 SW 1/4" or footage from lines
1980' FNL & 990' FWL
Lease Owner Hawkins Oil & Gas, Inc.
Lease Name THEIS Well No. 1-7
Office Address P.O. Box 1869 Liberal, KS 67901
Character of Well (Completed as Oil, Gas or Dry Hole)

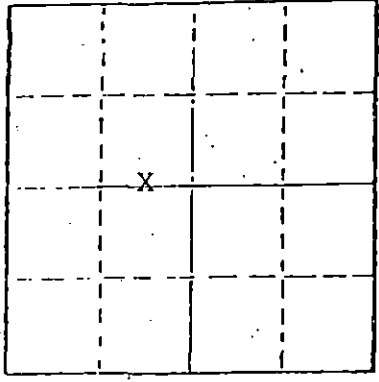

Locate well correctly on above Section Plot

Dry Hole
Date Well completed 9-7 1980
Application for plugging filed 19
Application for plugging approved 9-7 1980
Plugging commenced 9-7 1980
Plugging completed 6:30 PM on 9-7 1980
Reason for abandonment of well or producing formation
Dry Hole

If a producing well is abandoned, date of last production
N/A 19

Was permission obtained from the Conservation Division or its agents before plugging was commenced? yes

Name of Conservation Agent who supervised plugging of this well Clarence Thomas, Jr. Garden City, KS
Producing formation n/a Depth to top Bottom Total Depth of Well 6300'

Show depth and thickness of all water, oil and gas formations.

OIL, GAS OR WATER RECORDS

CASING RECORD

FORMATION	CONTENT	FROM	TO	SIZE	PUT IN	PULLED OUT
				8-5/8"	829'	-

Describe in detail the manner in which the well was plugged, indicating where the mud fluid was placed and the method or methods used in introducing it into the hold. If cement or other plugs were used, state the character of same and depth placed, from feet to feet for each plug set. Plugged well as follows:

- 60 sacks @ 800'
- 25 sacks @ 400'
- 10 sacks @ 40'
- 5 sacks in rat hole
- cut off pipe and welded on ID cap

RECEIVED
STATE CORPORATION COMMISSION
SEP 11 1980
CONSERVATION DIVISION
Wichita, Kansas

(If additional description is necessary, use BACK of this sheet)

Name of Plugging Contractor B J Hughes - Woodward, OK


STATE OF Kansas COUNTY OF Seward, ss.
Harold K. Frauli, Agent (employee of owner) or (owner or operator)
of the above-described well, being first duly sworn on oath, says: That I have knowledge of the facts, statements, and matters herein contained and the log of the above-described well as filed and that the same are true and correct. So help me God.

STATE OF KANSAS
STATE CORPORATION COMMISSION

WELL PLUGGING RECORD

Give All Information Completely
Make Required Affidavit
Mail or Deliver Report to
Conservation Division
State Corporation Comm.
245 North Water
Wichita, KS 67202

Clark County. Sec. 7 Twp. 35 SRge. 25 ~~SW~~
Location as "NE/CNW $\frac{1}{4}$ SW $\frac{1}{4}$ " or footage from lines
1980' FNL & 990' FWL
Lease Owner Hawkins Oil & Gas, Inc.
Lease Name THEIS Well No. 1-7
Office Address P.O. Box 1869 Liberal, KS 67901
Character of Well (Completed as Oil, Gas or Dry Hole)

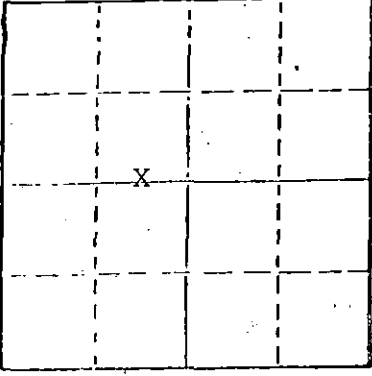

Locate well correctly on above Section Plot

Dry Hole
Date Well completed 9-7 19 80
Application for plugging filed 19
Application for plugging approved 9-7 19 80
Plugging commenced 9-7 19 80
Plugging completed 6:30 PM on 9-7 19 80
Reason for abandonment of well or producing formation
Dry Hole
If a producing well is abandoned, date of last production
N/A 19

Was permission obtained from the Conservation Division or its agents before plugging was commenced? yes

Name of Conservation Agent who supervised plugging of this well Clarence Thomas, Jr. Garden City, KS
Producing formation n/a Depth to top Bottom Total Depth of Well 6300'
Show depth and thickness of all water, oil and gas formations.


OIL, GAS OR WATER RECORDS

CASING RECORD

FORMATION	CONTENT	FROM	TO	SIZE	PUT IN	PULLED OUT
				8-5/8"	829'	-

Describe in detail the manner in which the well was plugged, indicating where the mud fluid was placed and the method or methods used in introducing it into the hold. If cement or other plugs were used, state the character of same and depth placed, from feet to feet for each plug set. Plugged well as follows:

- 60 sacks @ 800'
- 25 sacks @ 400'
- 10 sacks @ 40'
- 5 sacks in rat hole
- cut off pipe and welded on ID cap.

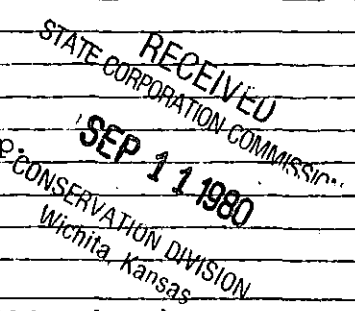

(If additional description is necessary, use BACK of this sheet)

Name of Plugging Contractor B J Hughes - Woodward, OK

STATE OF Kansas COUNTY OF Seward, ss.
Harold K. Frauli, Agent (employee of owner) or (owner or operator)
of the above-described well, being first duly sworn on oath, says: That I have knowledge of the facts, statements, and matters herein contained and the log of the above-described well as filed and that the same are true and correct. So help me God.

(Signature) Harold K. Frauli, Agent
P.O. Box 1869 Liberal, KS 67901
(Address)

SUBSCRIBED me this 9th day of September, 19 80



Debra L. Cochran
Notary Public.

My commission expires 12-7-82