


STATE OF KANSAS  
STATE CORPORATION COMMISSION

Form CP-4

All Information Completely  
Required Affidavit  
Per Deliver Report to:  
Conservation Division  
State Corporation Commission  
211 No. Broadway  
Wichita, Kansas

## WELL PLUGGING RECORD

NORTH

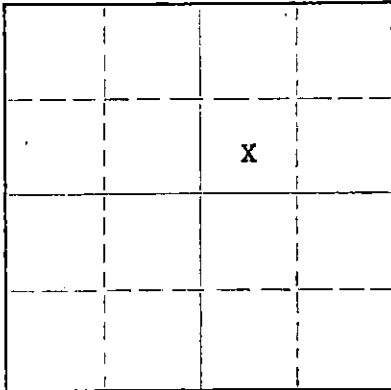Locate well correctly on above  
Section Plat

Clark County, Sec. 5 Twp. 35-SRge. (E) 25 (W)

Location as "NE/CNW/SW" or footage from lines SW NE  
Lease Owner. Ashland Oil & Refining Company  
Lease Name Theis Well No. 2  
Office Address 720 N.W. 50th - Oklahoma City  
Character of Well (completed as Oil, Gas or Dry Hole) Gas  
Date well completed January 22 19 62  
Application for plugging filed December 1 19 66  
Application for plugging approved December 5 19 66  
Plugging commenced February 10 19 67  
Plugging completed February 15 19 67  
Reason for abandonment of well or producing formation Depleted

If a producing well is abandoned, date of last production September 19 66  
Was permission obtained from the Conservation Division or its agents before plugging was commenced? Yes

Name of Conservation Agent who supervised plugging of this well E. Eves  
Producing formation Morrow Depth to top 5870 Bottom 5958 Total Depth of Well 6215 Feet  
Show depth and thickness of all water, oil and gas formations.

## OIL, GAS OR WATER RECORDS

## CASING RECORD

FORMATION	CONTENT	FROM	TO	SIZE	PUT IN	PULLED OUT
				8 5/8	542	0
				4 1/2	6029	3965

Describe in detail the manner in which the well was plugged, indicating where the mud fluid was placed and the method or methods used in introducing it into the hole. If cement or other plugs were used, state the character of same and depth placed, from feet to feet for each plug set.

Filled hole with mud. Shot casing at 4496' & 4000'. Pulled 126 joints of 4 1/2" Casing. Pumped 35 sack cement plug at 600'. Capped surface with 10 sacks cement.

RECEIVED  
STATE CORPORATION COMMISSION

APR 5 1967

4-5-67

CONSERVATION DIVISION  
WICHITA, KANSAS

(If additional description is necessary, use BACK of this sheet)

Name of Plugging Contractor Gayle E. Toland & Company  
Address Box 94336 Oklahoma City, Oklahoma 73109

STATE OF Oklahoma, COUNTY OF Oklahoma, ss:

ASHLAND OIL & REFINING COMPANY (employee of owner) or (owner or operator) of the above-described well, being first duly sworn on oath, says: That I have knowledge of the facts, statements, and matters herein contained and the log of the above-described well as filed and that the same are true and correct. So help me God.

Robert H. Tompkins  
Division Office Manager

(Signature)

Box 18695, Oklahoma City, Oklahoma 73118

(Address)

SUBSCRIBED AND SWORN to before me this 3rd day of April, 19 67

My commission expires

1-11-70

Donald R. Lunsford  
Notary Public.

15-025-00137-0000


WELL LOG BUREAU—KANSAS GEOLOGICAL SOCIETY  
508 East Murdock, Wichita, Kansas

Company- ASHLAND OIL & REFINING  
Farm- Theis No. 2

SEC. 5 T. 35 R. 25W  
C NE SW

Total Depth. 6047'  
Comm. 12-9-61 Comp. 1-2-62  
Shot or Treated.  
Contractor. Graham-Michaelis Drilg. Co.  
Issued. 4-28-62

County Clark  
KANSAS

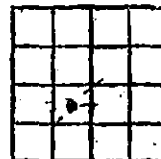

CASINO:  
8 5/8" 553.42' cem w/500 sx.  
4" 6039'

Elevation. 2087'

Production. 10,800,000 CFG

Figures Indicate Bottom of Formations.

red bed	1111
red bed & shale	1960
shale & gyp	2473
lime	2635
lime & shale	2835
lime	2905
lime & shale	3073
lime & chalk	3346
lime	3490
lime & shale	4043
shale	4576
lime & shale	5022
lime	5800
lime & shale	5854
lime	5892
lime & shale	5950
lime	6045 RTD
lime	6047

Total Depth

TOPS: SCOUT

Heebner	4372
Toronto	4410
Brown Lime	4552
Lansing	4579
Marmaton	5300
Cherokee	5468
Morrow	5798
Morrow Sand	5836
Chester	5876

RECEIVED  
STATE CORPORATION COMMISSION  
APR 10 1967  
CONSERVATION DIVISION  
Wichita, Kansas