


15-119-10348-0000

STATE OF KANSAS
STATE CORPORATION COMMISSION
Give All Information Completely
Make Required Affidavit
Mail or Deliver Report to:
Conservation Division
State Corporation Commission
211 No. Broadway
Wichita, Kansas

WELL PLUGGING RECORD

Meade County, Sec. 1 Twp. 34S Rge. (E) 30(W)
Location as "NE/CNW/SW" or footage from lines SW NENE
Lease Owner Thomas & Brewer
Lease Name Wancura Well No. 1
Office Address Box 985 - Liberal, Kansas
Character of Well (completed as Oil, Gas or Dry Hole) Dry Hole
Date well completed 3-12 19 60
Application for plugging filed 3-12 19 60
Application for plugging approved 3-12 19 60
Plugging commenced 3-12 19 60
Plugging completed 3-12 19 60
Reason for abandonment of well or producing formation Dry

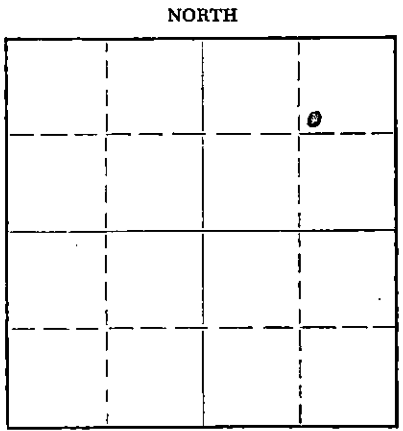

Locate well correctly on above Section Plat

If a producing well is abandoned, date of last production 19
Was permission obtained from the Conservation Division or its agents before plugging was commenced? Yes

Name of Conservation Agent who supervised plugging of this well Lackamp
Producing formation Depth to top Bottom Total Depth of Well Feet
Show depth and thickness of all water, oil and gas formations.

OIL, GAS OR WATER RECORDS

CASING RECORD

FORMATION	CONTENT	FROM	TO	SIZE	PUT IN	PULLED OUT

Describe in detail the manner in which the well was plugged, indicating where the mud fluid was placed and the method or methods used in introducing it into the hole. If cement or other plugs were used, state the character of same and depth placed, from feet to feet for each plug set.

Plug @ 554' with 1/2 sack hulls, 20 sacks cement thru drill pipe.
Plug @ 40' with 1/2 sack hulls, filled to cellar with 15 sacks cement

(If additional description is necessary, use BACK of this sheet)

Name of Plugging Contractor Bennett & Roberts
Address Russell, Kansas

STATE OF KANSAS, COUNTY OF SEWARD, ss.
Glenn F. Thomas (employee of owner) or (owner or operator) of the above-described well, being first duly sworn on oath, says: That I have knowledge of the facts, statements, and matters herein contained and the log of the above-described well as filed and that the same are true and correct. So help me God.

(Signature) Glenn F. Thomas
Box 985 - Liberal, Kansas (Address)

SUBSCRIBED AND SWORN TO before me this 18th day of March, 19 60

My commission expires November 5, 1962

Notary Public.



RECEIVED
STATE CORPORATION COMMISSION
MAR 21 1960
CONSERVATION DIVISION

THOMAS & BREWER
WANCURA #1

SW NE NE Sec. 1-34-30
Meade County, Kansas

RTD 6005'
Commenced 2/12/60
Completed 3/12/60

CONTRACTOR: Bennett & Roberts Drilling Co.
Set 8 5/8" @ 1466' w/650 sx cmt.

Top Soil & Sand	120
Sand	200
Sand & Clay	400
Sand	480
Sand, Shale & Red Bed	658
Red Bed & Shale	1010
Sand	1080
Sand, Shale & Shells	1459
Anhydrite	1478
Shale & Lime Streaks	1840
Lime & Shale	2335
Lime	2430
Lime & Shale	2524
Lime	2820
Lime & Shale Streaks	2890
Lime & Shale	3065
Lime	3215
Lime, Chalky	3295
Lime & Chalk	3443
Lime & Shale	3920
Shale	4085
Shale & Lime	4175
Shale	4405
Shale & Lime	4625
Lime	5091
Lime & Shale	5210
Lime	5248
Lime & Shale	5277
Lime	5545
Lime & Shale	6005

STATE OF KANSAS)
RUSSELL COUNTY) SS.

This is to certify that the above information is correct to the best of my knowledge.

BENNETT & ROBERTS DRILLING CO.

By Janice Lee Marshall

Subscribed and sworn to before me this 16th day of March, 1960.

Clara Sumner
Notary Public

My Commission Expires 6/17/60

RECEIVED
STATE CORPORATION COMMISSION
MAR 21 1960
REGISTRATION DIVISION
Kansas