


STATE OF KANSAS  
STATE CORPORATION COMMISSION

MAY - 5 1978

WELL PLUGGING RECORD

Give All Information Completely  
Make Required Affidavit  
Mail or Deliver Report to  
Conservation Division  
State Corporation Comm.  
245 North Water  
Wichita, KS 67202

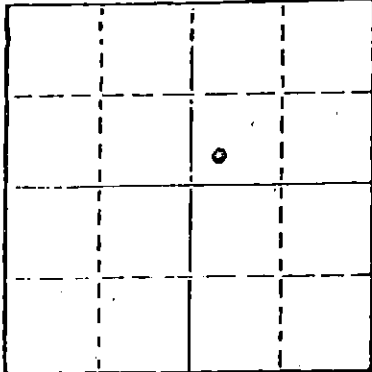

Locate well correctly on above  
Section Plat

Meade County Sec. 15 Twp. 34 Rge. 29W E/W  
Location as "NE/CNW 1/4 SW 1/4" or footage from lines  
C W/2 SW NE 1980' FNL & 2310' FEL  
Lease Owner Mesa Petroleum Co.  
Lease Name Ross Well No. 1-25  
Office Address Box 2009 Amarillo, Texas 79189  
Character of Well (Completed as Oil, Gas or Dry Hole)

Dry Hole  
Date Well completed 11/5/77 19  
Application for plugging filed April 10 1978  
Application for plugging approved April 12 1978  
Plugging commenced April 24 1978  
Plugging completed April 26 1978

Reason for abandonment of well or producing formation  
Not Productive  
If a producing well is abandoned, date of last production  
N/A 19

Was permission obtained from the Conservation Division or  
its agents before plugging was commenced? Yes

Name of Conservation Agent who supervised plugging of this well Clarence Thomas  
Producing formation Depth to top Bottom Total Depth of Well 6390  
Show depth and thickness of all water, oil and gas formations.

OIL, GAS OR WATER RECORDS

CASING RECORD

FORMATION	CONTENT	FROM	TO	SIZE	PUT IN	PULLED OUT
Toronto	Water	4490'	4500'	8 5/8	1468	none
Morrow	Water	5972'	5958'	2 7/8	6235	2915
/						

Describe in detail the manner in which the well was plugged, indicating where the mud fluid was placed and the method or methods used in introducing it into the hold. If cement or other plugs were used, state the character of same and depth placed, from feet to feet for each plug set.

- Pump 10 sks. of cement @ top 5100'
- Pump 10 sks. of cement @ top 4200'
- Pump 35 sks. of cement @ 3000 to 2900'
- Pump 50 sks. of cement @ 1400 to 1300'
- Put 10 sks. of cement @ 33 to 3'

RECEIVED  
STATE CORPORATION COMMISSION  
MAY 12 1978  
CONSERVATION DIVISION  
Wichita, Kansas

(If additional description is necessary, use BACK of this sheet)

Name of Plugging Contractor Sargents Casing Pulling service Box 506 Liberal, Kansas No. 511

STATE OF Texas COUNTY OF Potter, ss.  
George S. Dixon (employee of owner) or

of the above-described well, being first duly sworn on oath, says: That I have knowledge of the facts, statements, and matters herein contained and the log of the above-described well as filed and that the same are true and correct. So help me God.

(Signature) George S. Dixon  
Mesa Petroleum Co., P. O. Box 2009, Amarillo  
(Address) Tx. 79189

SUBSCRIBED AND SWORN TO before me this 9th day of May, 1978

Notary Public

My commission expires 2/28/79