


Give All Information Completely  
Make Required Affidavit  
Mail or Deliver Report to:  
Conservation Division  
State Corporation Commission

P. O. Box 17027  
Wichita, Kansas 67217  
NORTH

WELL PLUGGING RECORD

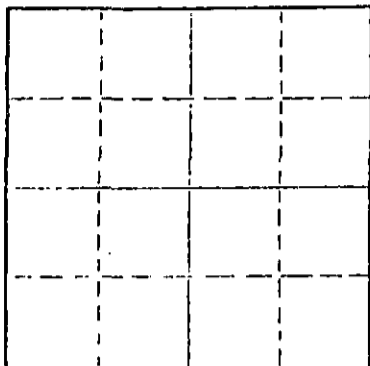

Locate well correctly on above  
Section Plat

Meade County, Sec. 31 Twp. 34S Rge. (E) 30(W)  
Location as "NE/CNW/SW" or footage from lines. C NW SE  
Lease Owner B & B Farm Industries, Inc.  
Lease Name Raymond Well No. 1  
Office Address 703 Collard, Spearman, Tex 79081  
Character of Well (completed as Oil, Gas or Dry Hole) Dry Hole  
Date well completed August 16, 19 75  
Application for plugging filed 19  
Application for plugging approved 19  
Plugging commenced August 16, 19 75  
Plugging completed August 16, 19 75  
Reason for abandonment of well or producing formation Dry Hole

If a producing well is abandoned, date of last production 19  
Was permission obtained from the Conservation Division or its agents before plugging was commenced? Yes (Clarence Thomas of Garden City)

Name of Conservation Agent who supervised plugging of this well  
Producing formation Depth to top Bottom Total Depth of Well Feet  
Show depth and thickness of all water, oil and gas formations.

OIL, GAS OR WATER RECORDS

CASING RECORD

FORMATION	CONTENT	FROM	TO	SIZE	PUT IN	PULLED OUT
	Surface Casing	0	1542'	8-5/8"	1542'	None

Describe in detail the manner in which the well was plugged, indicating where the mud fluid was placed and the method or methods used in introducing it into the hole. If cement or other plugs were used, state the character of same and depth placed, from feet to feet for each plug set.

Plugged Hole @ 1600 Feet w/70 sax Cement Plug,  
Heavy Mud to 45 Feet, 45 sax cement from 45  
Feet to 0, 2 sax cement in rat hole.  
Job Completed @ 7:15 P.M.

(If additional description is necessary, use BACK of this sheet)

Name of Plugging Contractor Halliburton  
Address R. R. 1, Box 112, Liberal, Ks. 67901

STATE OF KANSAS COUNTY OF SEDGWICK  
John R. Bartholomew of Sage Drilling Co. (employee of owner) or (owner or operator) of the above described


well being first duly sworn on oath, says: That I have knowledge of the facts, statements, and matters herein contained and the log of the above described well as filed and that the same are true and correct. So help me God.

(Signature) John R. Bartholomew  
500 Bitting Bldg., Wichita, Kansas  
(Address)

SUBSCRIBED AND SWORN TO before me this 21st day of August 19 75.

Louise K. Whitted  
Louise K. Whitted Notary Public.

My commission expires November 26, 1978.

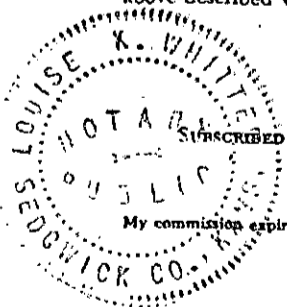

RECEIVED  
STATE CORPORATION COMMISSION

AUG 25 1975

CONSERVATION DIVISION  
Wichita, Kansas

DRILLERS LOG

RAYMOND NO. 1

CASING RECORD:	OPERATOR: B & B Farm Industries, Inc.	DESCRIPTION:
8-5/8" set 6" 1542 w/900 sax cement	CONTRACTOR: Sage Drilling Co., Inc.	C NW SE Sec. 31-34S-30W Meade Co., Kans.
TOTAL DEPTH: 4410'	COMMENCED: August 8, 1975	ELEVATION: 2469KB
	COMPLETED: August 16, 1975	

<u>FORMATION</u>	<u>FROM</u>	<u>TO</u>	<u>REMARKS</u>
Sand & Red Bed	0	440	
Red Bed	440	1160	
Sand & Anhydrite	1160	1545	
Anhydrite & Shale	1545	2212	
Anhydrite	2212	2560	
Anhydrite & Shale	2560	2750	
Dolomite	2750	3370	
Lime & Shale	3370	3630	
Shale & Lime	3630	3925	
Shale	3925	4105	
Shale & Lime	4105	4295	
Lime & Shale	4295	4410	D&A

I certify that this is a true and correct copy of the above log to the best of my knowledge.

SAGE DRILLING CO., INC.

By T. M. McCaul, Jr.  
T. M. McCaul, Jr.

Subscribed and sworn to before me this 18th day of August, 1975.

Louise K. Whitted  
Louise K. Whitted, Notary Public

My commission expires:  
November 26, 1978.

RECEIVED  
STATE CORPORATION COMMISSION

AUG 25 1975

CONSERVATION DIVISION  
Wichita, Kansas