


STATE OF KANSAS  
STATE CORPORATION COMMISSION

WELL PLUGGING RECORD

Give All Information Completely  
Make Required Affidavit  
Mail or Deliver Report to:  
Conservation Division  
State Corporation Commission  
212 No. Market  
Wichita, Kansas

Meade County, Sec. 31 Twp. 34S Rge. (E) 30 (W)  
C NE NE

Location as "NE/CNWKSWK" or footage from lines \_\_\_\_\_  
Lease Owner Blaik Oil Company  
Lease Name Raymond Well No. 1  
Office Address 203 Park Avenue, Oklahoma City, Oklahoma  
Character of Well (completed as Oil, Gas or Dry Hole) Dry Hole  
Date well completed 2-19-71 19  
Application for plugging filed 2-19-71 19  
Application for plugging approved 2-19-71 19  
Plugging commenced 2-19-71 19  
Plugging completed 2-19-71 19  
Reason for abandonment of well or producing formation Dry

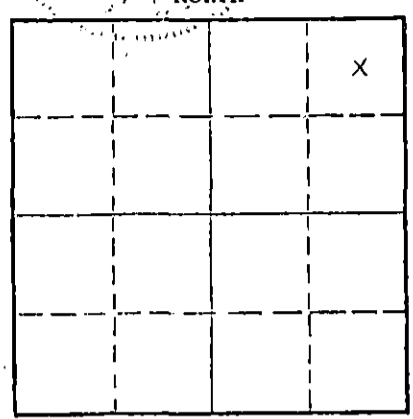

Locate well correctly on above Section Plat

If a producing well is abandoned, date of last production \_\_\_\_\_ 19  
Was permission obtained from the Conservation Division or its agents before plugging was commenced? Yes

Name of Conservation Agent who supervised plugging of this well \_\_\_\_\_  
Producing formation \_\_\_\_\_ Depth to top \_\_\_\_\_ Bottom \_\_\_\_\_ Total Depth of Well 4464' Feet  
Show depth and thickness of all water, oil and gas formations.

OIL, GAS OR WATER RECORDS

CASING RECORD

FORMATION	CONTENT	FROM	TO	SIZE	PUT IN	PULLED OUT
				8 5/8	1347.56'	

Describe in detail the manner in which the well was plugged, indicating where the mud fluid was placed and the method or methods used in introducing it into the hole. If cement or other plugs were used, state the character of same and depth placed, from \_\_\_\_\_ feet to \_\_\_\_\_ feet for each plug set.

35 sx. 1,000' to 900'  
15 sx. 45' to 0

RECEIVED  
STATE CORPORATION COMMISSION

MAR 4 1971 3-4-71

CONSERVATION DIVISION  
Wichita, Kansas

(If additional description is necessary, use BACK of this sheet)

Name of Plugging Contractor Zenith Drilling Corporation, Inc.  
Address Suite 600-200 West Douglas, Wichita, Kansas

STATE OF Kansas, COUNTY OF Sedgwick, ss.  
Max W. Satterthwaite (employee of owner) or (owner or operator) of the above-described

well, being first duly sworn on oath, says: That I have knowledge of the facts, statements, and matters herein contained and the log of the above-described well as filed and that the same are true and correct. So help me God.

(Signature) Max W. Satterthwaite  
Suite 600 - 200 W. Douglas, Wichita, Kansas  
(Address)

Subscribed and Sworn to before me this 1st day of March, 1971.



Aug. 15, 1971.

Myrna D. Murphy  
Notary Public.

# WELL LOG

COMPANY Blaik Oil Company

SEC. 31 T. 34S R. 30W

FARM Raymond

NO. 1

LOC. C NE NE

TOTAL DEPTH 4464'

COUNTY Meade County, Kansas

COMM. 2-10-71

COMP. 2-19-71

CONTRACTOR Zenith Drilling Corporation, Inc.

			X

CASING

8 5/8" w/650 sx.

ELEVATION

PRODUCTION D & A

FIGURES INDICATE BOTTOM OF FORMATIONS

- 40' to 475' Surface Sand & Clay
  - 475' to 1343' Surface Sand, Red Bed, and Anhydrite
  - 1343' to 2120' Shale
  - 2120' to 2470' Shale & Lime
  - 2470' to 3947' Lime
  - 3947' to 4464' Lime & Shale
- TD

RECEIVED  
STATE CONSERVATION COMMISSION  
MAR 4 1971  
CONSERVATION DIVISION  
Wichita, Kansas

State of Kansas }  
County of Sedgwick } SS

I, C. Robert Buford of Wichita, Kansas

upon oath state the above and foregoing is a true and correct copy of the log of the Raymond #1 well.

*Map W. Lattichewitz*

Subscribed and sworn to before me this 1st day of March 19 71.

My Commission Expires: August 15, 1971.

*Myrna S. Murphy*  
NOTARY PUBLIC

