

STATE OF KANSAS
STATE CORPORATION COMMISSION

Form CP-4


Give All Information Completely
Make Required Affidavit
Mail or Deliver Report to:
Conservation Division
State Corporation Commission
212 No. Market
Wichita, Kansas

WELL PLUGGING RECORD

Meade County, Sec. 30 Twp. 34 Rge. 30 (E) W (W)

Location as "NE/CNW/SW" or footage from lines C/SW/4-NW/4
Lease Owner Horizon Oil & Gas Co.
Lease Name Adams "C" Well No. 1-30
Office Address P. O. Box 7
Character of Well (completed as Oil, Gas or Dry Hole) Oil
Date well completed June 25, 19 69
Application for plugging filed Verbal November 7, 19 84
Application for plugging approved Verbal November 7, 19 84
Plugging commenced December 12, 19 84
Plugging completed December 20, 19 84
Reason for abandonment of well or producing formation Uneconomical

NORTH

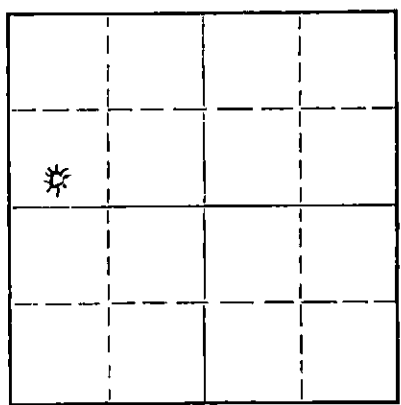

Locate well correctly on above Section Plat

If a producing well is abandoned, date of last production August 19 84
Was permission obtained from the Conservation Division or its agents before plugging was commenced? Yes

Name of Conservation Agent who supervised plugging of this well
Producing formation Lansing Depth to top 4190 Bottom 4196 Total Depth of Well 4378 Feet
Show depth and thickness of all water, oil and gas formations.

OIL, GAS OR WATER RECORDS CASING RECORD

FORMATION	CONTENT	FROM	TO	SIZE	PUT IN	PULLED OUT
Lansing	Oil	4190	4196	4 1/2"	4378	1955

Describe in detail the manner in which the well was plugged, indicating where the mud fluid was placed and the method or methods used in introducing it into the hole. If cement or other plugs were used, state the character of same and depth placed, from feet to feet for each plug set.

Pumped 1 sack cottonseed hulls and 25 sacks of class "H" cement. Hole loaded and pressured to 500# when hulls and cement reached perforations.

Cut off casing at 1955'.

- Spot 40 sacks of Class "H" at 1950'
- Spot 50 sacks of Class "H" at 1270'
- Spot 40 sacks of Class "H" at 660' - Cement did not hold.
- Spot 50 sacks of Class "H" from 1150 to 1250
- Spot 40 sacks of Class "H" from 550 to 650
- 10 sacks Class "H" from 0 to 40'

RECEIVED
STATE CORPORATION COMMISSION
JAN 02 1985
CONSERVATION DIVISION
Wichita, Kansas

(If additional description is necessary, use BACK of this sheet)

Name of Plugging Contractor Sargents Casing Pullers
Address Liberal, Kansas

STATE OF Texas, COUNTY OF Hansford, ss.
Curtis Covington (employee of owner) or (owner or operator) of the above-described well, being first duly sworn on oath, says: That I have knowledge of the facts, statements, and matters herein contained and the log of the above-described well as filed and that the same are true and correct. So help me God.

(Signature) Curtis T. Covington Engineer
P. O. Box 7, Spearman, Texas 79081
(Address)

SUBSCRIBED AND SWORN TO before me this 26th day of December, 19 84

(Signature) Notary Public.

My commission expires 5-85