


WELL PLUGGING RECORD

Give All Information Completely
Make Required Affidavit
Mail or Deliver Report to:
Conservation Division
State Corporation Commission
212 No. Market
Wichita, Kansas

Meade County, Sec. 30 Twp. 34S Rge. (E) 30 (W)

NORTH

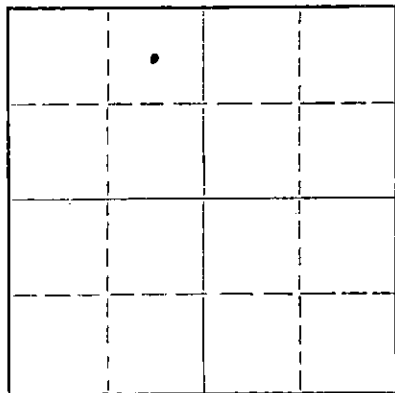

Locate well correctly on above Section Plat

Location as "NE/CNW/SW" or footage from lines C NE NW
Lease Owner Anadarko Production Company
Lease Name Holmes "A" Well No. 1
Office Address Box 351 Liberal, Kansas 67901
Character of Well (completed as Oil, Gas or Dry Hole) Dry Hole
Date well completed November 11 19 69
Application for plugging filed November 14 19 69
Application for plugging approved November 13 19 69
Plugging commenced November 11 19 69
Plugging completed November 11 19 69
Reason for abandonment of well or producing formation _____

If a producing well is abandoned, date of last production _____ 19 ____
Was permission obtained from the Conservation Division or its agents before plugging was commenced? Yes

Name of Conservation Agent who supervised plugging of this well Mr. Ed Eves, Box F, Sublette, Kansas 67877
Producing formation _____ Depth to top _____ Bottom _____ Total Depth of Well 4470 Feet
Show depth and thickness of all water, oil and gas formations.

OIL, GAS OR WATER RECORDS

CASING RECORD


FORMATION	CONTENT	FROM	TO	SIZE	PUT IN	PULLED OUT
				8 5/8"	1335'	None

Describe in detail the manner in which the well was plugged, indicating where the mud fluid was placed and the method or methods used in introducing it into the hole. If cement or other plugs were used, state the character of same and depth placed, from _____ feet to _____ feet for each plug set.

Spotted 35 sacks cement from 800' to 900' and 15 sacks cement from 45' to surface.
Hole was filled with mud below each plug.

RECEIVED
STATE CORPORATION COMMISSION
NOV 20 1969
CONSERVATION DIVISION
Wichita, Kansas

(If additional description is necessary, use BACK of this sheet)
Name of Plugging Contractor Earl F. Wakefield Drilling Company
Address Wichita, Kansas

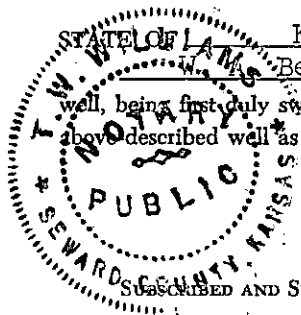

KANSAS, COUNTY OF SEWARD, ss.
W. A. Beatty (employee of owner) or (owner or operator) of the above-described well, being first duly sworn on oath, says: That I have knowledge of the facts, statements, and matters herein contained and the log of the above described well as filed and that the same are true and correct. So help me God.

(Signature) W. A. Beatty
W. A. Beatty
Box 351, Liberal, Kansas 67901
(Address)

Subscribed and Sworn to before me this 19th day of November, 19 69

J.W. Williams
Notary Public.

My Commission Expires April 28, 1971

My commission expires _____

DRILLER'S LOG

WELL NAME: Holmes "A" No. 1 ; COMPANY OPERATING: Anadarko Production Company
 ADDRESS of COMPANY: Box 351 Liberal, Kansas 67901
 WELL LOCATION: C 1/4 NE 1/4 NW 1/4,
4620 ft. North of South line,
1980 ft. East of West line: Sec. 30, Twp. 34S, Rge. 30W, Meade County, Kansas
 DRILLING STARTED Nov. 1, 1969; DRILLING COMPLETED Nov. 9, 1969
 WELL COMPLETED Nov. 11, 1969; WELL CONNECTED _____, 19____
 ELEVATION: 2489.8 ft. Ground Level; CHARACTER OF WELL (Oil, Gas, or Dry Hole) Dry Hole

OIL OR GAS SANDS OR ZONES - PERFORATIONS - ACIDIZING AND FRACTURING INFORMATION					
Name	From	To	No. of Shots	Gallons Used	Kind Used

RECEIVED
 STATE CORPORATION COMMISSION
 NOV 20 1969
 CONSERVATION DIVISION
 Wichita, Kansas

CASING RECORD

Size	Amount Set	Sacks of Cement	Amount Pulled
8 5/8"	1335'	730	None

FORMATION RECORD

Formation	Top	Bottom	Formation	Top	Bottom
Clay & Sand	0'	425'	Lime & Shale	4020'	4265'
Red Bed	425'	830'	Lime	4265'	4470'
Shale & Shells	830'	1247'	Total Depth	4470'	
Shale & Anhydrite	1247'	1395'			
Shale & Shells	1395'	1730'			
Shale & Lime	1730'	2240'			
Lime & Shale	2240'	2395'			
Lime	2395'	2795'			
Lime & Shale	2795'	3230'			
Lime	3230'	3385'			
Lime & Shale	3385'	3645'			
Shale & Lime	3645'	3815'			
Lime	3815'	4020'			

RESULTS of INITIAL PRODUCTION TEST: _____

