


15-119-10271-0000

STATE OF KANSAS
STATE CORPORATION COMMISSION

Give All Information Completely
Make Required Affidavit
Mail or Deliver Report to:
Conservation Division
State Corporation Commission
212 North Market, Insurance Bldg.
Wichita, Kansas

WELL PLUGGING RECORD

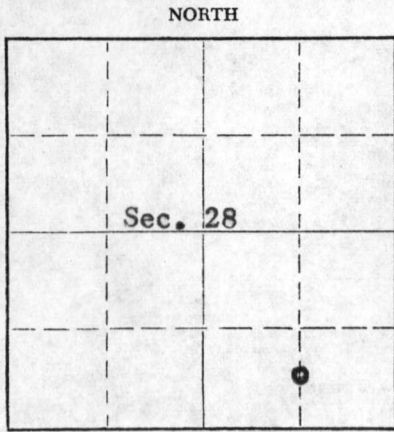

Locate well correctly on above
Section Plat

Meade County. Sec. 28 Twp. 34S Rge. (E) 30 (W)
Location as "NE/CNW/SW" or footage from lines C-S₂-SE₄
Lease Owner Stekoll Panhandle Limited Partnership
Lease Name Adams Ranch Well No. 1-28
Office Address P.O. Box Z Perryton, Texas
Character of Well (completed as Oil, Gas or Dry Hole) Dry
Date well completed April 21 19 60
Application for plugging filed April 20 19 60
Application for plugging approved 19
Plugging commenced April 21 8:00AM 19 60
Plugging completed April 21 5:00 19 60
Reason for abandonment of well or producing formation Dry Hole

If a producing well is abandoned, date of last production N.A. 19
Was permission obtained from the Conservation Division or its agents before plugging was commenced? Yes

Name of Conservation Agent who supervised plugging of this well W.L. Lackamp
Producing formation None Depth to top Bottom Total Depth of Well 6206 Feet
Show depth and thickness of all water, oil and gas formations.

OIL, GAS OR WATER RECORDS

CASING RECORD

FORMATION	CONTENT	FROM	TO	SIZE	PUT IN	PULLED OUT
Cimarron		1485	3021	8-5/8	1470	None
Council Grove		3021	4438			
Toronto		4438	5256			
Marmaton		5256	5815			
Morrow Sd		5815	5953			
Miss.	Water	5953				

Describe in detail the manner in which the well was plugged, indicating where the mud fluid was placed and the method or methods used in introducing it into the hole. If cement or other plugs were used, state the character of same and depth placed, from feet to feet for each plug set.

Well full of heavy drilling mud, set wooden plug at 600' and cemented with 25 sacks from 600' to 517', set wooden plug at 300' and cemented with 25 sacks from 300' to 217' and weld steel plate on top of 8-5/8" surface casing.

RECEIVED
MAY 2 1960
KANSAS CORPORATION COMMISSION

Name of Plugging Contractor Self (If additional description is necessary, use BACK of this sheet)
Address _____

STATE OF Texas, COUNTY OF Ochiltree, ss.
C.H. Stewart (employee of owner) or (owner or operator) of the above-described well, being first duly sworn on oath, says: That I have knowledge of the facts, statements, and matters herein contained and the log of the above-described well as filed and that the same are true and correct. So help me God.

(Signature) C.H. Stewart

P.O. Box Z Perryton, Texas
(Address)

SUBSCRIBED AND SWORN TO before me this 28 day of April, 19 60

Ann Brady
Notary Public.

My commission expires 6/1/61



Stekoll Petroleum Company
 P. O. Box 1115
 Perryton, Texas

Adams Ranch Well No. 1-28, 660' from south line and 1320' from east line,
 Sec. 28-34S-30W, Meade County, Kansas.

Drilling Commenced March 28, 1960
 Drilling Completed April 24, 1960

Casing Record:
 1370' of 8 5/8" Casing - 800 Sacks

<u>Formations</u>	<u>Top</u>	<u>Bottom</u>
Shale & Red Bed	0	2435
Shale	2435	2500
Shale & Lime	2500	2832
Sandy Lime & Shale	2832	2925
Lime & Shale	2925	3040
Lime & Sand	3040	3081
Shale & Lime	3081	3620
Lime & Chalk	3620	3684
Shale, Lime & Chalk	3684	3738
Lime & Shale	3738	3978
Shale	3978	4055
Shale & Lime	4055	4138
Shale & Shells	4138	4306
Lime & Shale	4306	4342
Sand & Lime	4342	4400
Shale & Lime	4400	4540
Shale	4540	4625
Shale & Lime	4625	4846
Sandy Lime & Shale	4846	4900
Lime & Shale	4900	5000
Sandy Lime & Shale	5000	5042
Sand, Lime & Shale	5042	5122
Lime & Shale	5122	5461
Lime	5461	5521
Lime & Shale	5521	6206 TD

RECEIVED
 STATE CORPORATION COMMISSION
 MAY 3 1960
 CONSERVATION DIVISION
 Wichita, Kansas