

STATE OF KANSAS
STATE CORPORATION COMMISSION

WELL PLUGGING RECORD

Give All Information Completely
Make Required Affidavit
Mail or Deliver Report to
Conservation Division
State Corporation Comm.
245 North Water
Wichita, KS 67202

Meade County, Sec. 12 Twp. 34S Rge. 30W E/W
Location as "NE/CNW $\frac{1}{4}$ SW $\frac{1}{4}$ " or footage from lines


SW SW SE
Lease Owner Funk Exploration Co.
Lease Name Bender Well No. 1
Office Address 100 Park Ave. Bldg. #220 Okla. City, Okla 73102
Character of Well (Completed as Oil, Gas or Dry Hole) Dry

Date Well completed February 20, 1979
Application for plugging filed 19
Application for plugging approved May 10, 1979
Plugging commenced 5-10 1979
Plugging completed 5-14 1979
Reason for abandonment of well or producing formation Dry Hole

If a producing well is abandoned, date of last production NA 19

Was permission obtained from the Conservation Division or its agents before plugging was commenced? Yes

Name of Conservation Agent who supervised plugging of this well Clarence Thomas
Producing formation None Depth to top Bottom Total Depth of Well 6100
Show depth and thickness of all water, oil and gas formations.

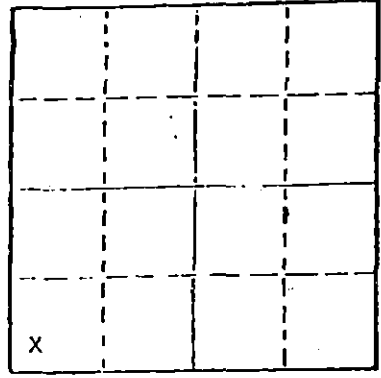

OIL, GAS OR WATER RECORDS

CASING RECORD

FORMATION	CONTENT	FROM	TO	SIZE	PUT IN	PULLED OUT
Chester	Show of oil	5994	6032	8 5/8	1474	none
	Went to H ₂ O			4 1/2	6099	3011

Describe in detail the manner in which the well was plugged, indicating where the mud fluid was placed and the method or methods used in introducing it into the hold. If cement or other plugs were used, state the character of same and depth placed, from feet to feet for each plug set.

Pump 20 sks. of cement & 1 sk. of hull's @ 6032 to 5800
Pump 35 sks. of cement @ 1524 to 1424
Put 10 sks. of cement @ 40 to 0

RECEIVED
STATE CORPORATION COMMISSION

JUL 30 1979

7-30-79

CONSERVATION DIVISION
Wichita, Kansas

(If additional description is necessary, use BACK of this sheet)

Name of Plugging Contractor Sargent's Casing Pulling Ser. Box 506 Liberal, Kansas 67901 Ks. No. 511

STATE OF Oklahoma COUNTY OF Oklahoma, ss.
James D. Vaught, Consultant for Funk Exp., Inc. (employee of owner) or (owner or operator)

of the above-described well, being first duly sworn on oath, says: That I have knowledge of the facts, statements, and matters herein contained and the log of the above-described well as filed and that the same are true and correct. So help me God.

(Signature) James D. Vaught
1st Nat'l Cen.-545W, Okla. City, OK 73102
(Address)

SUBSCRIBED AND SWORN TO before me this 26th day of July, 1979

[Signature]
Notary Public.

My commission expires October 26, 1980

DRILLER'S LOG

COMPANY: Funk Exploration, Inc.

SEC. 12 T. 34S R. 30W

WELL NAME: Bender #1

LOC. C SW SW SE

COUNTY: Meade

RIG NO. #2

TOTAL DEPTH 6100'

ELEVATION

COMMENCED: 1-20-79

COMPLETED: 2-10-79

CONTRACTOR: Rains & Williamson Oil Co., Inc.

CASING RECORD:

SURFACE: 8 5/8" @ 1474' w/600 sx. 65/35 poz., 3% cc. and 100 sx.
Class H, 3% cc.

PRODUCTION: 4 1/2" @ 6099' w/165 sx. 50/50 poz., 10% salt, .75 PIC.

LOG

(Figures Indicate Bottom of Formations)

Sand & Clay	415
Sand & Shale	750
Shale	2643
Shale & Lime	2950
Lime & Shale	5160
Shale & Lime	2275
Lime & Shale	5480
Lime, Shale & Sand	5595
Lime & Shale	5940
Lime	6020
Lime & Shale	6095
Lime	6100
<u>ROTARY TOTAL DEPTH</u>	<u>6100</u>

RECEIVED
STATE CORPORATION COMMISSION

MAY 11 1979

CONSERVATION DIVISION
Wichita, Kansas

STATE OF Kansas)

COUNTY OF Sedgwick)

SS:

I, Wilson Rains, President of Rains & Williamson Oil Co., Inc.

upon oath state that the above and foregoing is a true and correct copy of the log of the

Bender #1 well.

Wilson Rains

Wilson Rains

Subscribed and sworn to before me this 14 day of February, 1979.

My Appointment Expires:



JUANITA M. GREEN
STATE NOTARY PUBLIC
Sedgwick County, Kansas
My Appt. Exp. 10/4/79

Juanita M. Green
Juanita M. Green