


STATE OF KANSAS  
STATE CORPORATION COMMISSION

Form CP-4

Give All Information Completely  
Make Required Affidavit  
Mail or Deliver Report to:  
Conservation Division  
State Corporation Commission  
212 No. Market  
Wichita, Kansas

WELL PLUGGING RECORD

NORTH

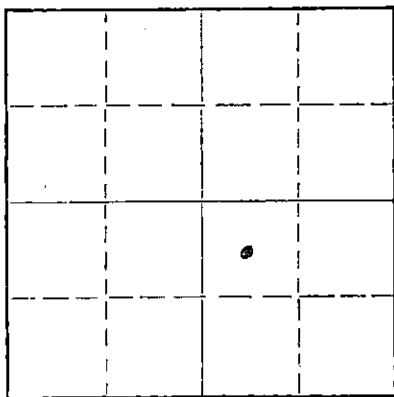

Locate well correctly on above  
Section Plat

Meade County. Sec. 11 Twp. 34S Rge. (E) 30 (W)  
Location as "NE/CNWSW" or footage from lines 1980' FSL & 1980' FEL  
Lease Owner Anadarko Production Company  
Lease Name Fox "E" Well No. 1  
Office Address Box 351 Liberal, Kansas 67901  
Character of Well (completed as Oil, Gas or Dry Hole) Dry Hole  
Date well completed March 18 19 70  
Application for plugging filed March 24 19 70  
Application for plugging approved Verbal approval March 18 19 70  
Plugging commenced March 18 19 70  
Plugging completed March 18 19 70  
Reason for abandonment of well or producing formation

If a producing well is abandoned, date of last production 19  
Was permission obtained from the Conservation Division or its agents before plugging was commenced? Yes

Name of Conservation Agent who supervised plugging of this well Mr. Ed Eves Sublette, Kansas  
Producing formation Depth to top Bottom Total Depth of Well Feet  
Show depth and thickness of all water, oil and gas formations.

OIL, GAS OR WATER RECORDS

CASING RECORD

FORMATION	CONTENT	FROM	TO	SIZE	PUT IN	PULLED OUT

Describe in detail the manner in which the well was plugged, indicating where the mud fluid was placed and the method or methods used in introducing it into the hole. If cement or other plugs were used, state the character of same and depth placed, from feet to feet for each plug set.

Spotted 45 sacks cement 1600' - 1450'

Spotted 20 sacks cement 700' - 620'

Spotted 15 sacks cement 45' to surface.

Hole filled with mud between each plug.

RECEIVED  
STATE CORPORATION COMMISSION  
MAR 26 1970  
CONSERVATION DIVISION  
Wichita, Kansas

(If additional description is necessary, use BACK of this sheet)

Name of Plugging Contractor Leonard Hudson Drilling Company  
Address Pampa, Texas

STATE OF Kansas, COUNTY OF Seward, ss.  
V. K. Downey (employee of owner) or (owner or operator) of the above-described

well, being first duly sworn on oath, says: That I have knowledge of the facts, statements, and matters herein contained and the log of the above described well as filed and that the same are true and correct. So help me God.

(Signature) V. K. Downey

Box 351, Liberal, Kansas 67901 (Address)

Subscribed and sworn to before me this 24th day of March, 19 70



J. W. Williams Notary Public.

My Commission Expires April 28, 1971

My commission expires

DRILLER'S LOG

WELL NAME Fox "E" No. 1 COMPANY OPERATING Anadarko Production Company  
 ADDRESS OF COMPANY Box 351, Liberal, Kansas 67901

WELL LOCATION C  $\frac{1}{4}$  NW  $\frac{1}{4}$  SE  $\frac{1}{4}$   
1980 Ft. North of South Line,  
3286 Ft. East of West Line, Sec. 11, Twp. 34S, Rge. 30W, Meade County, Kansas

DRILLING STARTED 2-28, 19 70, DRILLING COMPLETED 3-18, 19 70  
 WELL COMPLETED 3-18, 19 70, WELL CONNECTED \_\_\_\_\_, 19 \_\_\_\_\_

ELEVATION 2657.2 Ft. Ground Level. CHARACTER of WELL (Oil, Gas, Dry Hole) Dry Hole

OIL OR GAS SANDS OR ZONES - PERFORATIONS - ACIDIZING AND FRACTURING INFORMATION					
Name	From	To	No. of Shots	Gallons Used	Kind Used

RECEIVED  
 STATE CORPORATION COMMISSION  
 MAR 26 1970  
 CONSERVATION DIVISION  
 Wichita, Kansas

CASING RECORD

Size	Amount Set	Sacks of Cement	Amount Pulled
8 5/8"	1537	775	None

FORMATION RECORD

Formation	Top	Bottom	Formation	Top	Bottom
Surface sand & redbed	0	905	Shale & Lime	5036	5139
Redbed, Sand, Anhydrite	905	1549	Lime & Shale	5139	6004
Anhydrite, Shale	1549	1737	Sand & Shale	6004	6068
Shale, Anhydrite	1737	2077	Lime & Shale	6068	6150
Shale, Anhydrite, Lime	2077	2554	Shale & Lime	6150	6234
Lime & Shale	2554	2678	Lime & Shale	6234	6300
Dolomite	2678	2831	Shale & Lime	6300	6378
Lime & Shale	2831	3011	Lime & Shale	6378	6504
Dolomite	3011	3346	Total Depth	6504	
Dolomite & Shale	3346	3676			
Lime & Shale	3676	3832			
Shale & Lime	3832	4523			
Lime & Shale	4523	5036			

RESULTS OF INITIAL PRODUCTION TEST: D & A