

15-119-00214-0000

STATE OF KANSAS
STATE CORPORATION COMMISSION

Give All Information Completely
Make Required Affidavit
Mail or Deliver Report to:
Conservation Division
State Corporation Commission
211 No. Broadway
Wichita, Kansas

WELL PLUGGING RECORD

Meade County. Sec. 6 Twp. 34S Rge. (E) 30 (W)

Location as "NE/CNW/SW" or footage from lines C NW/4 SW/4

Lease Owner William Gruenerwald

Lease Name Young & Demoret Well No. 1

Office Address 35 East Wacker Drive, Chicago, Illinois

Character of Well (completed as Oil, Gas or Dry Hole) Dry Hole

Date well completed December 8, 1964

Application for plugging filed December 8, 1964


Application for plugging approved (verbal) December 8, 1964

Plugging commenced December 8, 1964

Plugging completed December 8, 1964

Reason for abandonment of well or producing formation Non commercial

NORTH

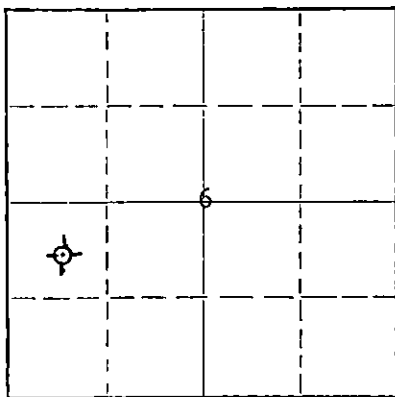

Locate well correctly on above Section Plat

If a producing well is abandoned, date of last production 19

Was permission obtained from the Conservation Division or its agents before plugging was commenced? yes (verbal)

Name of Conservation Agent who supervised plugging of this well Hugh Scott, Box F., Sublette, Kansas

Producing formation none Depth to top Bottom Total Depth of Well 6088 Feet

Show depth and thickness of all water, oil and gas formations.

OIL, GAS OR WATER RECORDS

CASING RECORD

FORMATION	CONTENT	FROM	TO	SIZE	PUT IN	PULLED OUT
				8 5/8"	1437'	none

Describe in detail the manner in which the well was plugged, indicating where the mud fluid was placed and the method or methods used in introducing it into the hole. If cement or other plugs were used, state the character of same and depth placed, from feet to feet for each plug set.

Filled hole with heavy drilling mud, cement plug at 700' with 35 sacks cement.
Filled hole with heavy drilling mud, cement plug at 45' with 15 sacks cement.
Plug on top of surface casing.

RECEIVED
STATE CORPORATION COMMISSION

DEC 16 1964

CONSERVATION DIVISION
Wichita, Kansas

(If additional description is necessary, use BACK of this sheet)

Name of Plugging Contractor Graham Michaelis Drilling Company

Address 211 North Broadway, Wichita, Kansas 67202

STATE OF Kansas, COUNTY OF Sedgwick, ss.

John L. James (employee of owner) or (owner or operator) of the above-described well, being first duly sworn on oath, says: That I have knowledge of the facts, statements, and matters herein contained and the log of the above-described well as filed and that the same are true and correct. So help me God.

(Signature) John L. James

211 North Broadway, Wichita, Kansas 67202 (Address)

SUBSCRIBED AND SWORN TO before me this 14th day of December, 1964

Evelyn D. Evans Notary Public.

My commission expires December 12, 1966

YOUNG & DEMORET #1

WELL RECORD:

LOCATION:

C NW SW Section 6-34S-30W
Meade County, Kansas

Commenced: 11-23-64
Completed: 12-8-64
(Rotary)

CONTRACTOR:

Graham-Michaelis Drilling Co.
Liberal Division
P. O. Box 1294
Liberal, Kansas

CASING RECORD:

45 Joints 24# 8-5/8" Casing
Cemented w/550 sx Pozmix 4% Gel
2% cc followed w/150 sx Common
2% cc

Sand & Red Bed
Red Bed & Gyp
Red Bed
Lime & Shale
Lime
Lime & Shale
Lime
Lime & Shale
Lime
Lime & Shale
Lime

LOG

0 - 805
805 - 1438
1438 - 2120
2120 - 3012
3012 - 3140
3140 - 4135
4135 - 4332
4332 - 4606
4606 - 5696
5696 - 5783
5783 - 6088

RECEIVED
STATE CORPORATION COMMISSION

DEC 16 1964

CONSERVATION DIVISION
Wichita, Kansas

6088' - Total Rotary Depth

The undersigned, Graham-Michaelis Drilling Company, Liberal Division, certifies that the above log is a true and correct copy of the formations encountered in drilling the above mentioned well, as taken from the Daily Drilling Report.

GRAHAM-MICHAELIS DRILLING COMPANY
LIBERAL DIVISION

By H. R. Michaelis
H. R. Michaelis