


WELL PLUGGING RECORD

Give All Information Completely  
Make Required Affidavit  
Mail or Deliver Report to:  
Conservation Division  
State Corporation Commission  
211 No. Broadway  
Wichita, Kansas

NORTH

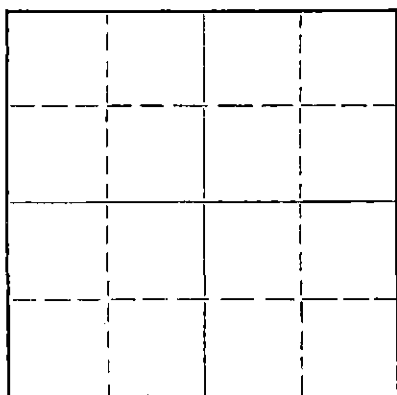

Locate well correctly on above  
Section Plat

Pratt County, Sec. 33 Twp. 28S Rge. 12 (XXXX) (W)

Location as "NE/CNW/SW" or footage from lines NE NE SW  
Lease Owner Anderson Prichard Oil Corporation  
Lease Name Barnes Unit Well No. 1  
Office Address Liberty Bank Bldg., Oklahoma City 2, Okla.  
Character of Well (completed as Oil, Gas or Dry Hole) Dry Hole  
Date well completed June 4 1960  
Application for plugging filed June 4 1960  
Application for plugging approved June 4 1960  
Plugging commenced June 4 1960  
Plugging completed June 4 1960  
Reason for abandonment of well or producing formation no oil and/or gas found  
in commercial quantities  
If a producing well is abandoned, date of last production \_\_\_\_\_ 19\_\_\_\_  
Was permission obtained from the Conservation Division or its agents before plugging was commenced? yes

Name of Conservation Agent who supervised plugging of this well Fred Hampel  
Producing formation \_\_\_\_\_ Depth to top \_\_\_\_\_ Bottom \_\_\_\_\_ Total Depth of Well 4640 Feet  
Show depth and thickness of all water, oil and gas formations.

OIL, GAS OR WATER RECORDS

CASING RECORD

FORMATION	CONTENT	FROM	TO	SIZE	PUT IN	PULLED OUT
				8-5/8"	900'	none

Describe in detail the manner in which the well was plugged, indicating where the mud fluid was placed and the method or methods used in introducing it into the hole. If cement or other plugs were used, state the character of same and depth placed, from \_\_\_\_\_ feet to \_\_\_\_\_ feet for each plug set.

Filled hole with extra heavy rotary mud from total depth to 300'. Set Plug #1 at 300' with 1/4 sx. Halls, 15 sacks cement. Filled hole with extra heavy rotary mud from top of plug #1 to 40'. Set Plug #2 at 40' with 1/4 sx. Halls, 10 sacks cement.


RECEIVED  
STATE CORPORATION COMMISSION  
JUN 15 1960  
CONSERVATION DIVISION  
Wichita, Kansas

(If additional description is necessary, use BACK of this sheet)  
Name of Plugging Contractor Prime Drilling Company  
Address 814 Union Center, Wichita, Kansas

STATE OF Kansas, COUNTY OF Sedgwick, ss.  
R. R. McNicol (employee of owner) or (owner or operator) of the above-described well, being first duly sworn on oath, says: That I have knowledge of the facts, statements, and matters herein contained and the log of the above-described well as filed and that the same are true and correct. So help me God.

(Signature) R.R. McNicol  
814 Union Center, Wichita, Kansas  
(Address)

SUBSCRIBED AND SWORN to before me this 7th day of June, 1960

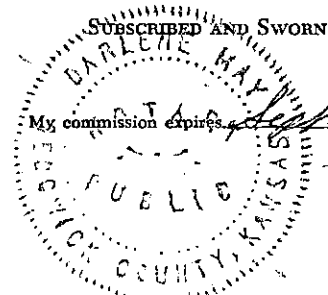

Darlene May  
Notary Public.

ROTARY DRILLING LOG

OPERATOR: Anderson Prichard Oil Corporation  
BARNES UNIT NO. 1  
 NE NE SW Sec. 33-28S-12W,  
 Pratt County, Kansas

CONTRACTOR: Prime Drilling Company  
 COMM: 5-18-60  
 COMP: 6-4-60

Remarks: Set 8-5/8" surface casing  
 at 900' cemented with 600  
 sacks Pozmix, 3% C.C.

Formations:

Sand & Shale	270'
Red Bed & Shale	410'
Red Bed	680'
Red Bed & Shale	893'
Lime	901'
Lime & Shale	920'
Shale & Shells	1165'
Shale	1500'
Shale & Shells	1810'
Lime	1925'
Lime & Shale	2010'
Lime	2085'
Lime & Shale	2725'
Shale & Lime Streaks	2890'
Lime & Shale	3010'
Lime	3640'
Lime & Shale	3800'
Lime	4490'
Lime Cherty	4525'
Sand	4564'
Lime	4640'
Rotary Total Depth (D&A)	4640'

RECEIVED  
 STATE CORPORATION COMMISSION  
 JUN 15 1960  
 CONSERVATION DIVISION  
 Wichita, Kansas

We certify the above log is true  
 and correct to the best of our  
 knowledge and belief.

PRIME DRILLING COMPANY

*R. R. McNicol*

R. R. McNicol