


15,151-00046-00 00

STATE OF KANSAS
STATE CORPORATION COMMISSION

Give All Information Completely
Make Required Affidavit
Mail or Deliver Report to:
Conservation Division
State Corporation Commission
211 No. Broadway
Wichita, Kansas

WELL PLUGGING RECORD

NORTH

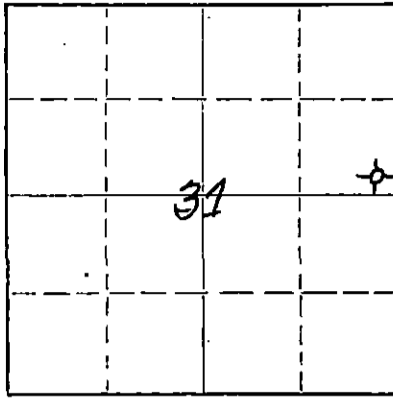

Locate well correctly on above
Section Plat

Pratt County, Sec. 31 Twp 28S Rge. 12 XEXX (W)
Location as "NE/CNW/SW" or footage from lines SE SE NE
Lease Owner D. R. Lauck Oil Company, Inc.
Lease Name Dietz Well No. 1
Office Address 301 So. Broadway Wichita 2 Kansas
Character of Well (completed as Oil, Gas or Dry Hole) dry hole
Date well completed March 1 19 58
Application for plugging filed " 19 58
Application for plugging approved " 19 58
Plugging commenced " 19 58
Plugging completed " 19 58
Reason for abandonment of well or producing formation dry hole

If a producing well is abandoned, date of last production -- 19
Was permission obtained from the Conservation Division or its agents before plugging was commenced? YES

Name of Conservation Agent who supervised plugging of this well
Producing formation Depth to top Bottom Total Depth of Well 4677 Feet
Show depth and thickness of all water, oil and gas formations.

OIL, GAS OR WATER RECORDS

CASING RECORD

FORMATION	CONTENT	FROM	TO	SIZE	PUT IN	PULLED OUT
		0	322	8 5/8"	322	none

Describe in detail the manner in which the well was plugged, indicating where the mud fluid was placed and the method or methods used in introducing it into the hole. If cement or other plugs were used, state the character of same and depth placed, from feet to feet for each plug set.

hole filled with mud 4677 - 320
plug 320 - 316
cement 316 - 276
mud 276 - 35
plug 35 - 31
cement 31 - 6
bottom of cellar

FILED
STATE CORPORATION COMMISSION
MAR 8 1956 03-08-58
CONSERVATION DIVISION
Wichita, Kansas

(If additional description is necessary, use BACK of this sheet)
Name of Plugging Contractor Globe Cementing Company
Address Great Bend Kans

STATE OF Kansas, COUNTY OF Sedgwick, ss.
John H. Knightley (employee of owner) or (owner or operator) of the above-described well, being first duly sworn on oath, says: That I have knowledge of the facts, statements, and matters herein contained and the log of the above-described well as filed and that the same are true and correct. So help me God.

(Signature) John H. Knightley
Wichita Kansas
(Address)

SUBSCRIBED AND SWORN TO before me this 6th day of March, 19 58

My commission expires Sept. 14, 1959
Elizabeth Gay Notary Public.

PLUGGING
FILE SEC 31 T 28 R 12W
BOOK PAGE 58 LINE 13

D. R. Lauck Oil Company, Inc.

Dietz #1

SE SE NE Sec.31-28S-12W
Pratt County Kansas

Commenced: February 10, 1958

Completed: March 1, 1958

Casing Record: 322' 8 5/8" cem.with 225 sacks
calcium chloride 4 sacks

Elevation: GR 1890; DF 1892; KB 1894

Drillers Log

		Tops	
		Sample	Schlumberger
clay	80	Heebner	3612-1718 3607-1713
sand	120	Toronto	3627-1733 3624-1730
shale	135	Douglas	3643-1749 3640-1746
sand	230	Brown Lime	3802-1908 3800-1906
red bed	660	Lansing Kansas City	3816-1922 3812-1918
red bed, shale & sand	980	Mississippian	4263-2369 4260-2366
shale	1260	Kinderhook	4374-2480 4368-2474
shale & shells	1880	Viola	4423-2529 4414-2520
Anhydrite (2nd)	1955	Simpson shale	4526-2632 4524-2630
lime & shale	2690	Simpson sand	4529-2635 4534-2640
shale & shells	2870	Arbuckle	4648-2754 4648-2754
shale & lime	3130	Rotary Total Depth	4677-2783 4675-2781
lime broken	3310		
chalky lime	3450		D & A
lime & shale	3730		
lime	4263		
Mississippian chert	4285		
lime & chert	4351		
shale	4435		
Viola	4460		
lime & chert	4533		
shale & Lime	4554		
Simpson	4570		
sand & shale	4615		
shale	4619		
shale & Lime	4650		
Arbuckle	4677	RTD	

REC
STATE CORPORATION

MAR 8 1958

CONSERVATION DIVISION
Wichita, Kansas

PLUGGING
SEC 31 T 28 R 12W
BOOK PAGE 88 LINE 13