


WELL PLUGGING RECORD

Give All Information Completely
Make Required Affidavit
Mail or Deliver Report to:
Conservation Division
State Corporation Commission
212 North Market, Insurance Bldg.
Wichita, Kansas

Pratt County. Sec. 31 Twp. 28S Rge. 12W (E) (W)
Location as "NE/CNW%SW%" or footage from lines SW NE NE
Lease Owner Wilkinson Drilling Co.
Lease Name Deitz Estate Well No. # 1
Office Address 818 E 10th Great Bend, Kansas
Character of Well (completed as Oil, Gas or Dry Hole) _____
Date well completed _____ 19____
Application for plugging filed yes 19____
Application for plugging approved yes 19____
Plugging commenced 11-28-59 19____
Plugging completed ~~11-28-59~~ 12-6-59 19____
Reason for abandonment of well or producing formation _____

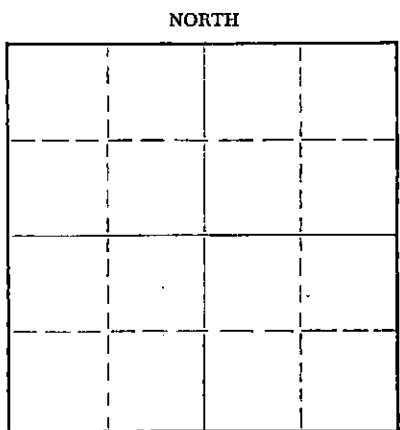

Locate well correctly on above Section Plat

If a producing well is abandoned, date of last production _____ 19____
Was permission obtained from the Conservation Division or its agents before plugging was commenced? yes

Name of Conservation Agent who supervised plugging of this well Mr. Fred Hampel
Producing formation _____ Depth to top _____ Bottom _____ Total Depth of Well 4551' Feet
Show depth and thickness of all water, oil and gas formations.

OIL, GAS OR WATER RECORDS

CASING RECORD

FORMATION	CONTENT	FROM	TO	SIZE	PUT IN	PULLED OUT
				5 1/2"		3,672'

Describe in detail the manner in which the well was plugged, indicating where the mud fluid was placed and the method or methods used in introducing it into the hole. If cement or other plugs were used, state the character of same and depth placed, from _____ feet to _____ feet for each plug set.

Measured into total depth 4551'.
Plugging commenced: 11-28-59. Plugging completed: 12-6-59
Plugged off bottom: Sanded back to 4420' and dumped 5 sacks of cement. Worked pipe. Loaded hole with water. Worked and shot pipe. Pumped in 105 barrels of water. Pumped in 72 barrels of oil. Displaced plug with 88 barrels of water. Shot 5 1/2" casing at 3672'. Pulled and laid down pipe, after building rack and slide. Bailed fluid down hole and filled hole to 220'. Set 10' rock bridge and dumped 20 sacks of cement. Mudded hole to 35'. Set 10' rock bridge at 35'. Capped the well with 10 sacks of cement.

RECEIVED
STATE CORPORATION COMMISSION

APR 22 1964

04-22-64
CONSERVATION DIVISION
Wichita, Kansas

(If additional description is necessary, use BACK of this sheet)
Name of Plugging Contractor J. O. Forbes d/b/a Forbes Casing Pulling Company
Address Box 221, Great Bend, Kansas

STATE OF Kansas, COUNTY OF Barton, ss.
J. O. Forbes (employee of owner) or (owner or operator) of the above-described well, being first duly sworn on oath, says: That I have knowledge of the facts, statements, and matters herein contained and the log of the above-described well as filed and that the same are true and correct. So help me God.

(Signature) J. O. Forbes
Box 221, Great Bend, Kansas
(Address)

SUBSCRIBED AND SWORN TO before me this 8 day of Dec, 1959
Arthur F. Shickel
Notary Public.

My commission expires April 8, 1961

DEC 9 REC'D

August 5, 1959

DIETZ ESTATE #1

Company - WILKINSON DRILLING, INC.
 Contractor - Corpany Tools
 Commenced - July 15, 1959
 Completed - August 3, 1959
 Total Depth - 4551'

Location - SW NE NE, Sec. 31-28s-12w,
 Pratt County, Kansas
 Elevation - 1899' KB
 Casing - 8 5/8" @ 266' w/175 sacks

FIGURES INDICATE BOTTOMS OF FORMATIONS

Depth


Formations

Sand and shale.
 Shale and shells.
 ANHYDRITE.
 Shale and shells.
 Lime and shale.
 Shale and lime.
 Lime and shale.
 Lime.
 Lime and shale.
 Lime.
 Mississippi.
 Chert.
 Lime.
 Mississippi.
 Mississippi and Kinderhook.
 Lime.
 Viola.

RECEIVED
 STATE CORPORATION COMMISSION

APR 22 1964

CONSERVATION DIVISION
 Topeka, Kansas

We hereby certify the above and foregoing to be a true and correct copy of the Log on the DIETZ ESTATE #1, located in the SW NE NE, Sec. 31-28s-12w, Pratt County, Kansas.

WILKINSON DRILLING, INC.

Walter M. Wilkinson
 Walter M. Wilkinson

Subscribed and sworn to before me this fifth day of August, nineteen hundred and fifty-nine.

Carolyn K. Moore
 Carolyn K. Moore

My commission expires January 2, 1961.