

STATE OF KANSAS
STATE CORPORATION COMMISSION

WELL PLUGGING RECORD

Give All Information Completely
Make Required Affidavit
Mail or Deliver Report to
Conservation Division
State Corporation Comm.
245 North Water
Wichita, KS 67202

Meade County. Sec. 28 Twp. 34 Rge. 27 ~~W~~/W
Location as "NE/CNW $\frac{1}{4}$ SW $\frac{1}{4}$ " or footage from lines C SW/4


Lease Owner Wainoco Inc. 1100 Milam Bldg. Houston Tex.
Lease Name Barby Well No. 1-28
Office Address 1100 Milam Bldg. Houston, Texas
Character of Well (Completed as Oil, Gas or Dry Hole) Dry Hole

Date Well completed 12-18-76 19
Application for plugging filed 12-15 & 12-18-76 19
Application for plugging approved 12-15 & 12-18-76 19
Plugging commenced 12-15 & 12-18-76 19
Plugging completed 12-15 & 12-18-76 19

Reason for abandonment of well or producing formation Dry Hole
If a producing well is abandoned, date of last production 19

Was permission obtained from the Conservation Division or its agents before plugging was commenced? Yes

Name of Conservation Agent who supervised plugging of this well Clarence Thomas
Producing formation Nil Depth to top Bottom Total Depth of Well 6200
Show depth and thickness of all water, oil and gas formations.

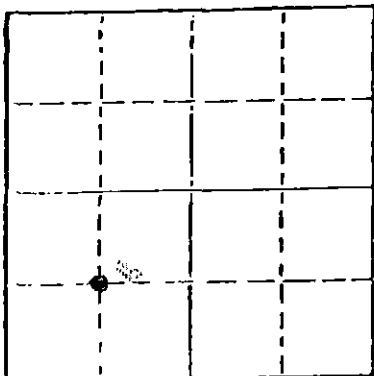

Locate well correctly on above Section Plat

OIL, GAS OR WATER RECORDS

CASING RECORD

FORMATION	CONTENT	FROM	TO	SIZE	PUT IN	PULLED OUT
Surface		GL	1940	8 5/8	X	
Dry						

Describe in detail the manner in which the well was plugged, indicating where the mud fluid was placed and the method or methods used in introducing it into the hold. If cement or other plugs were used, state the character of same and depth placed, from feet to feet for each plug set.

35 Sx Cement 3185-3110 by Haliburton 50 1940-1750 by Haliburton
15 Sx 40-GL by Haliburton

RECEIVED
STATE CORPORATION COMMISSION

FEB 24 1977 2-24-77

CONSERVATION DIVISION
Wichita, Kansas

(If additional description is necessary, use BACK of this sheet)

Name of Plugging Contractor Rotary-Zenith Drlg. Co.

STATE OF Oklahoma COUNTY OF Beaver, ss.
 (employee of owner) or (owner or operator)
of the above-described well, being first duly sworn on oath, says: That I have knowledge of the facts, statements, and matters herein contained and the log of the above-described well as filed and that the same are true and correct. So help me God.

(Signature) Bill D

Box 642 Beaver Okla.
(Address)

SUBSCRIBED AND SWORN TO before me this 23 day of February, 1977

Virginia Cooper
Notary Public.

My commission expires July 2, 1977