

STATE OF KANSAS
STATE CORPORATION COMMISSION

WELL PLUGGING RECORD


Give All Information Completely
Make Required Affidavit
Mail or Deliver Report to
Conservation Division
State Corporation Comm.
245 North Water
Wichita, KS 67202

Meade County. Sec. 27 Twp. 34S Rge. 27 XW
Location as "NE/CNW₁/SW₄" or footage from lines _____

C SE
Lease Owner Mesa Petroleum Company
Lease Name Merkle Well No. 1-27

Office Address P. O. Box 1578, Liberal, Kansas 67901
Character of Well (Completed as Oil, Gas or Dry Hole) _____
dry hole

Date Well completed 11-27 1979
Application for plugging filed _____ 19____
Application for plugging approved _____ 19____
Plugging commenced 11-30 1979
Plugging completed 11-30 1979
Reason for abandonment of well or producing formation _____
dry hole

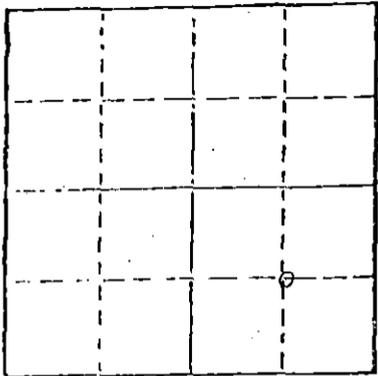

Locate well correctly on above
Section Plat

If a producing well is abandoned, date of last production _____
19____

Was permission obtained from the Conservation Division or
its agents before plugging was commenced? yes

Name of Conservation Agent who supervised plugging of this well Clarence Thomas, Jr.
Producing formation _____ Depth to top _____ Bottom _____ Total Depth of Well _____
Show depth and thickness of all water, oil and gas formations.

OIL, GAS OR WATER RECORDS

CASING RECORD

FORMATION	CONTENT	FROM	TO	SIZE	PUT IN	PULLED OUT
				8 5/8"	714	none

Describe in detail the manner in which the well was plugged, indicating where the mud fluid
was placed and the method or methods used in introducing it into the hold. If cement or other
plugs were used, state the character of same and depth placed, from _____ feet to
_____ feet for each plug set.

Plugged well as follows: 50 sacks @ 700'
10 sacks @ 40-0'
5 sacks rathole
Completed @ 9:30AM, 11-30-79

RECEIVED
CONSERVATION DIVISION
Wichita, Kansas 67202
DEC - 5 1979

(If additional description is necessary, use BACK of this sheet)

Name of Plugging Contractor Dowell, Ulysses, Kansas 67580

STATE OF Kansas COUNTY OF Seward, ss.
Harold K. Frauli (employee of owner) or (owner or operator)

of the above-described well, being first duly sworn on oath, says: That I have knowledge of
the facts, statements, and matters herein contained and the log of the above-described well
as filed and that the same are true and correct. So help me God.

(Signature) Harold K. Frauli, Agent
Box 1578, Liberal, Kansas 67901
(Address)

SUBSCRIBED AND SWORN TO before me this 3rd day of December, 1979

My commission expires _____


Bettie Hutchinson
Notary Public.

15-119-20376-0000

DRILLERS LOG

MERKLE NO. 1-27

CASING RECORD:	OPERATOR: Mesa Petroleum Company	DESCRIPTION:
8-5/8" set @ 714' w/600 sax cement	CONTRACTOR: Sage Drilling Co., Inc.	1980' FSL & 1980' FEL of
TOTAL DEPTH:	COMMENCED: November 14, 1979	Sec. 27-34S-27W
6177'	COMPLETED: November 30, 1979	Meade County, Kansas.

<u>FORMATION</u>	<u>FROM</u>	<u>TO</u>	<u>REMARKS</u>
Red Bed	0	743	
Red Bed & Sand	743	1175	
Sand & Shale	1175	1988	
Shale & Lime	1988	2155	
Shale	2155	2402	
Shale & Lime	2402	2610	
Lime & Shale	2610	2657	Ran DST #1
Lime & Shale	2657	3240	
Shale & Lime	3240	3510	
Lime & Shale	3510	3923	
Shale & Lime	3923	4110	
Lime & Shale	4110	4520	
Shale & Lime	4520	4606	
Lime & Shale	4606	4653	
Shale & Lime	4653	4790	
Lime & Shale	4790	6177	Logged Hole, Ran DST #2 & DST #3, D & A.

RECEIVED
STATE CORPORATION COMMISSION

I certify that this is a true and correct copy of the log on the above captioned well to the best of my knowledge. DEC 16 1979

CONSERVATION DIVISION
SAGE DRILLING CO., INC.

By John R. Bartholomew
John R. Bartholomew

Subscribed and sworn to before me this 4th day of December, 1979.

Louise K. Whitted
Louise K. Whitted, Notary Public

My Commission expires:
November 26, 1982.

