


STATE OF KANSAS
STATE CORPORATION COMMISSION

Give All Information Completely
Make Required Affidavit
Mail or Deliver Report to:
Conservation Division
State Corporation Commission
211 No. Broadway
Wichita, Kansas

WELL PLUGGING RECORD

Meade County, Sec. 25 Twp. 34S Rge. 27W (E) (W)

Location as "NE/CNW/SW" or footage from lines C SW NE
Lease Owner Sunray Mid-Continent Oil Company
Lease Name Emily Pennick Well No. 1
Office Address 321 West Douglas - Wichita, Kansas
Character of Well (completed as Oil, Gas or Dry Hole) Oil
Date well completed February 21 19 61
Application for plugging filed August 9 19 61
Application for plugging approved August 11 19 61
Plugging commenced August 4 19 61
Plugging completed August 6 19 61
Reason for abandonment of well or producing formation Depleted

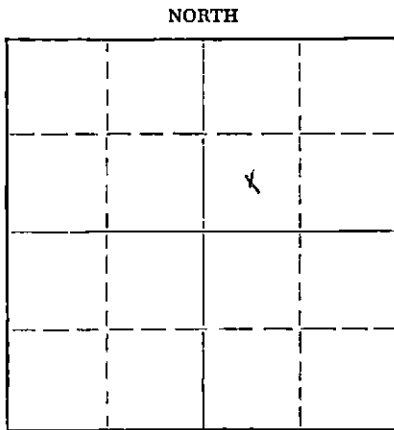

Locate well correctly on above
Section Plat

If a producing well is abandoned, date of last production June 8 19 61
Was permission obtained from the Conservation Division or its agents before plugging was commenced? Yes

Name of Conservation Agent who supervised plugging of this well Frank Broadfoot
Producing formation Morrow Depth to top 5965 Bottom TD Total Depth of Well 6100 Feet
Show depth and thickness of all water, oil and gas formations.

OIL, GAS OR WATER RECORDS

CASING RECORD

FORMATION	CONTENT	FROM	TD	SIZE	PUT IN	PULLED OUT
Cherokee	Water	5592	5629	20"	43'	0
Atoka	Dry	5748	5761	8-5/8"	1524'	0
Morrow	Oil & water	5965	TD	4-1/2"	6098'	5500'

Describe in detail the manner in which the well was plugged, indicating where the mud fluid was placed and the method or methods used in introducing it into the hole. If cement or other plugs were used, state the character of same and depth placed, from _____ feet to _____ feet for each plug set.

Hole filled with sand to 5892' and with mud from 5892' to 500'. Rock bridge at 500' and from 500' to 446'. Filled with mud from 446' to 35' and set rock bridge at 35'. Filled hole to surface from 35' with 10 sacks cement.

RECEIVED
STATE CORPORATION COMMISSION

AUG 16 1961

CONSERVATION DIVISION
Wichita, Kansas

(If additional description is necessary, use BACK of this sheet)

Name of Plugging Contractor Forbes Casing Pulling Company
Address Great Bend, Kansas

STATE OF Kansas, COUNTY OF Sedgewick, ss.
Nash A. Gough (employee of owner) by (owner) by (operator) of the above-described well, being first duly sworn on oath, says: That I have knowledge of the facts, statements and matters herein contained and the log of the above-described well as filed and that the same are true and correct. So help me God.

(Signature)

321 West Douglas - Wichita, Kansas
(Address)

SUBSCRIBED AND SWORN TO before me this 15th day of August, 19 61

My commission expires July 13, 1963

Notary Public.



15-119-10314-0000

Sunray Mid-Continent Oil Company
Tulsa, Oklahoma

Tulsa, Oklahoma
January 27, 1961

Contractors: Stickle Drilling Company
Date Commenced: December 24, 1960
Date Completed: January 24, 1960

Emily Pennick Unit No. 1
SW NE Sec. 25-34S-27W
Meade County, Kansas

DRILLER'S LOG

Depth Figures Indicate Base of Formations:

Shale	455
Red Bed	860
Red Bed and shale	1190
Shale and anhydrite	1435
Shale	1943
Shale w/lm. streaks	2408
Shale and lime	2680
Lime and shale	2780
Shale and lime	2917
Lime and shale	3023
Lime	3250
Lime and shale	3365
Shale w/lm. streaks	3570
Lime and shale	3651
Shale w/lm. streaks	3816
Lime and shale	4060
Shale w/lm. streaks	4260
Shale and lime	4607
Lime w/streaks of shale	4746
Lime	5930
Lime and shale	5976
Lime	6100 TD

I, Fred E. Stickle, hereby certify the above to be a true and complete Driller's Log of Sunray Mid-Continent Oil Company's Emily Pennick Unit No. 1, SW/4 NE/4 of Section 25-34S-27W., Meade County, Kansas.

Fred E. Stickle
Fred E. Stickle

Edith A. Lawrence
Notary Public

My commission expires March 24, 1964.

RECEIVED
STATE CORPORATION COMMISSION
AUG 16 1961
CONSERVATION DIVISION
Wichita, Kansas