

15-119-20286-0000

STATE OF KANSAS
STATE CORPORATION COMMISSION
200 Colorado Derby Bldg.
Wichita, Kansas 67202

STATE CORPORATION COMMISSION Form CP-4
Rev. 12-15-80


FEB 7 1983

CONSERVATION DIVISION
Wichita, Kansas

WELL PLUGGING RECORD

Give All Information Completely
Make Required Affidavit

COUNTY Meade SEC. 24 TWP. 34 S RGE. 27 E/W
Location as in quarters or footage from lines:
2500' ESL & 1250' FWL

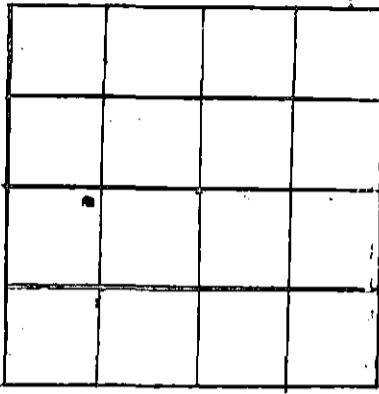

Locate Well
correctly on above
Section Platt.

Lease Owner Mesa Petroleum Co.
Lease Name Pinnick Well No. # 1-24
Office Address P.O. Box 2009 / Amarillo, Texas 79189
Character of Well (Completed as Oil, Gas or Dry Hole): Gas
Date Well Completed 10-19-77
Application for plugging filed 9-29-82
Plugging commenced 1-12-83
Plugging completed 1-14-83
Reason for abandonment of well or producing formation Non-economical

Was permission obtained from the Conservation Division or it's Agent's before plugging was commenced? yes

Name of Conservation Agent who supervised plugging of this well Bob Tarbutton
Producing formation Chester Depth to top 6109' bottom 6204' T.D. 6516'
Show depth and thickness of all water, oil and gas formations.

OIL, GAS OR WATER RECORDS Casing Record

Formation	Content	From	To	Size	Put in	Pulled Out
Chester	Gas	6109	6130	10 3/4"	1522'	None
				2 7/8"	6343'	1540.55

Describe in detail the manner in which the well was plugged, indicating where the mud fluid was placed and the method or methods used in introducing it into the hold. If cement or other plugs were used, state the character of same and depth placed, from 6100 feet to 0 feet for each plug set.

1-13, Pumped 25 sks. cem. to 6100'. Shot pipe @ 1537'. Pumped 125 sks. cem. from 1537'-1314'. 1-14, Pumped 50 sks. cem. from 750'-650'. Capped w/20 sks. cem. from 40'-0'. Welded on steel plate w/name & date using 9.5 lbs. 38 visc. mud between plugs.

(If additional description is necessary, use BACK of this sheet)

Name of Plugging Contractor Mike Proctor's Casing Pullers, Inc.
3022 NW Expwy, #305, Okla. City, OK 73112

STATE OF Texas COUNTY OF Potter, ss.
R. E. Mathis (employee of owner) or (owner or operator) of the above-described well, being first duly sworn on oath, says: That I have knowledge of the facts, statements, and matters herein contained and the log of the above-described well as filed and that the same are true and correct. So help me God.

(Signature) R. E. Mathis
P.O. Box 2009/Amarillo, TX 79189
(Address)

SUBSCRIBED AND SWORN TO before me this 3rd day of February, 1983

Jan Rogers
Notary Public.

My Commission expires: 4/13/85

Recvd. Ama. Prod.

OCT 13 1977

DRILLERS LOG

PINNICK NO. 1-24

JLF
SD

GD
TLS

CASING RECORD:	OPERATOR: Mesa Petroleum Co.	DESCRIPTION:
10-3/4" set @ 1520' w/ 900 sax of cement	CONTRACTOR: Sage Drilling Co.	1250' FWL & 2500' FSL
TOTAL DEPTH: 6516'	COMMENCED: September 15, 1977	Sec. 24-34S-27W Meade County, Kansas.
	COMPLETED: October 2, 1977	

<u>FORMATION</u>	<u>FROM</u>	<u>TO</u>	<u>REMARKS</u>
Sand & Red Bed	0	518	
Red Bed & Shale	518	1540	
Red Bed, Anhydrite & Shells	1540	2220	
Red Bed & Shale	2220	2610	
Anhydrite & Shale	2610	2940	
Dolomite & Shale	2940	3125	
Lime & Shale	3125	6051	Ran DST#1
Lime & Shale	6051	6215	Ran DST#2
Lime & Shale	6215	6516	Logged Hole 2-7/8" Tubing Set @ 6338' w/ 200' sax of Pozmix

I certify that this is a true and correct copy of the log on the above captioned well to the best of my knowledge.

SAGE DRILLING CO., INC.

BY T. M. McCaul, Jr.
T. M. McCaul, Jr.



Subscribed and sworn to before me on this 11th day of October, 1977.

Louise K. Whitted
Louise K. Whitted, Notary Public

My commission expires:
November 26, 1978.

RECEIVED
STATE CORPORATION COMMISSION

DEC 1 1982

CONSERVATION DIVISION
Wichita, Kansas