


WELL PLUGGING RECORD

Give All Information Completely
Make Required Affidavit
Mail or Deliver Report to:
Conservation Division
State Corporation Commission
212 No. Market
Wichita, Kansas

Meade County. Sec. 24 Twp. 34S Rge. (E) 27 (W)

Location as "NE/CNW/SW" or footage from lines C NE
Lease Owner J. M. Huber Corporation
Lease Name Rogers Unit Well No. 1
Office Address P. O. Box 831, Borger, Texas 79007
Character of Well (completed as Oil, Gas or Dry Hole) Gas
Date well completed 6-21-1960
Application for plugging filed 6-26-1974
Application for plugging approved 6-28-1974
Plugging commenced 7-7-1974
Plugging completed 7-17-1974
Reason for abandonment of well or producing formation Uneconomical

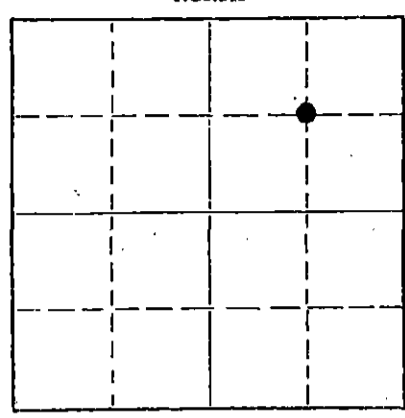

Locate well correctly on above Section Plat

If a producing well is abandoned, date of last production June 1974
Was permission obtained from the Conservation Division or its agents before plugging was commenced? Yes

Name of Conservation Agent who supervised plugging of this well Edgar Eves
Producing formation Morrow & Chester Depth to top 5986 Bottom 6162 Total Depth of Well 6206 Feet
6164 PBTD
Show depth and thickness of all water, oil and gas formations.

OIL, GAS OR WATER RECORDS				CASING RECORD		
FORMATION	CONTENT	FROM	TO	SIZE	PUT IN	PULLED OUT
Morrow	Gas	5986	6022	8 5/8	1422	None
Chester	Gas	6044	6162	5 1/2	6205	3205

Describe in detail the manner in which the well was plugged, indicating where the mud fluid was placed and the method or methods used in introducing it into the hole. If cement or other plugs were used, state the character of same and depth placed, from _____ feet to _____ feet for each plug set.

Cement plug #1 - 35 sx - top @ 5885' - bottom @ 6164'
Cement plug #2 - 30 sx - top @ 800' - bottom @ 900'
Cement plug #3 - 10 sx - top @ 2 1/2' - bottom @ 40'

Hole filled w/mud between plugs
5 1/2" casing shot off @ 3205'

RECEIVED
STATE CORPORATION COMMISSION
JUL 26 1974
CONSERVATION DIVISION
Wichita, Kansas

(If additional description is necessary, use BACK of this sheet)

Name of Plugging Contractor Sargent's Casing Pulling Service
Address P. O. Box 506, Liberal, Kansas 67901

STATE OF TEXAS, COUNTY OF HUTCHINSON, ss.
John L. Dannelley (employee of owner) or (owner or operator) of the above-described

well, being first duly sworn on oath, says: That I have knowledge of the facts, statements, and matters herein contained and the log of the above-described well as filed and that the same are true and correct. So help me God.

(Signature) [Signature]
P. O. Box 831, Borger, Texas 79007
(Address)

SUBSCRIBED AND SWORN TO before me this 23rd day of July, 19 74

My Commission Expires June 1, 1975

[Signature]
Notary Public.

My commission expires _____

Maryle M. Chambliss
Notary Public
In & for Hutchinson County, Texas

15-119-10262-0000

GABBERT-JONES DRILLING CO., INC.

WICHITA, KANSAS

DRILLER'S WELL LOG

RECEIVED
STATE CORPORATION COMMISSION
JUN 28 1974
CONSERVATION DIVISION
Wichita, Kansas

ROGERS #1
C NE 1/4 SECTION 24-34S-27W
MEADE COUNTY, KANSAS

COMMENCED: APRIL 1, 1960
COMPLETED: APRIL 25, 1960

OPERATOR - J. M. HUBER CORPORATION

DEPTH		FORMATION	REMARKS
FROM	TO		
0	100	SHALE & SAND	
100	645	RED SHALE & SHELLS	
645	1160	RED ROCK, SHALE & SHELLS	
1160	1375	SHALE & SHELLS	
1375	1422	ANHYDRITE	RAN 1422' OF 8-5/8" CASING, CEMENTED W/800 SACKS CEMENT.
1422	1635	SHALE & SHELLS	
1635	1885	SHALE & LIME	
1885	2290	SHALE	
2290	2715	LIME & SHALE	
2715	2789	LIME	
2789	3575	LIME & SHALE	
3575	3730	BROKEN LIME	
3730	4300	LIME & SHALE	
4300	4402	SHALE & SHELLS	
4402	4655	LIME & SHALE	
4655	5385	LIME	
5385	5460	LIME & SHALE	
5460	5856	LIME	
5856	5905	LIME & SHALE	
5905	5975	LIME	
5975	5995	SHALE & SAND	
5995	6206	LIME	
6206	TD		RAN 6206' OF 5-1/2" CASING, CEMENTED @ 6206' W/150 SACKS CEMENT.

I, E. E. HALL, CERTIFY THIS IS A TRUE AND CORRECT COPY OF THE DRILLER'S WELL LOG FOR THE ROGERS #1 WELL.

E. E. Hall
E. E. HALL

STATE OF KANSAS)
) SS
COUNTY OF SEDGWICK)

BEFORE ME, THE UNDERSIGNED, A NOTARY PUBLIC WITHIN AND FOR SAID COUNTY AND STATE, ON THIS 27TH DAY OF APRIL, 1960, PERSONALLY APPEARED E. E. HALL, TO ME PERSONALLY KNOWN TO BE THE IDENTICAL PERSON WHO EXECUTED THE WITHIN AND FOREGOING INSTRUMENT AND ACKNOWLEDGED TO ME THAT HE EXECUTED THE SAME AS HIS FREE AND VOLUNTARY ACT AND DEED FOR THE USES AND PURPOSES THEREIN SET FORTH.

IN WITNESS WHEREOF, I HAVE HEREUNTO SET MY HAND AND OFFICIAL SEAL THE DAY AND YEAR LAST ABOVE WRITTEN.

Vira A. McKenzie
VIRA A. MCKENZIE, NOTARY PUBLIC

MY COMMISSION EXPIRES OCTOBER 2, 1963.

WELL LOG

Well: Rogers #1
 Operator: J. M. Huber Corporation, P.O. Box 978, Liberal, Kansas
 Location: C-NE, Section 24, Twp. 34 S, Rge. 27W,
 Meade County, Kansas
 Elevation: G L - 2403
 Rig Commenced: 4-3-60
 Rig Completed: 4-25-60
 T.D. 6206'

FORMATIONS:	From	To
Shale & shells		645
Red bed & shale	645 -	1,160
Shale & shells	1,160 -	1,375
Lime	1,375 -	1,422
Shale & shells	1,422 -	1,635
Lime	1,635 -	1,885
Shale	1,885 -	2,290
Lime & shale	2,290 -	2,715
Lime	2,715 -	2,789
Lime & shale	2,789 -	3,575
Lime	3,575 -	3,730
Lime & shale	3,730 -	3,899
Lime	3,899 -	4,023
Lime & shale	4,023 -	4,655
Lime	4,655 -	5,385
Lime & shale	5,385 -	5,460
Lime	5,460 -	5,856
Lime & shale	5,856 -	5,905
Lime	5,905 -	6,206
T.D.	6,206	

RECEIVED
 STATE CORPORATION COMMISSION
 MAR 17 1971
 CONSERVATION DIVISION
 Wichita, Kansas

I, the undersigned, being first duly sworn upon oath, state that this well log is true and correct according to the records of this office and to the best of my knowledge and belief.

Bob Conley
 Bob Conley
 District Production Clerk

Subscribed and sworn to before me this 15th day of March, 1971.
 My commission expires June 1, 1971.

Cynthia Barclay
 Cynthia Barclay
 Notary Public, Potter Co., Texas