


STATE OF KANSAS
STATE CORPORATION COMMISSION

Give All Information Completely
Make Required Affidavit
Mail or Deliver Report to:
Conservation Division
State Corporation Commission
800 Bittling Building
Wichita, Kansas

WELL PLUGGING RECORD

NORTH

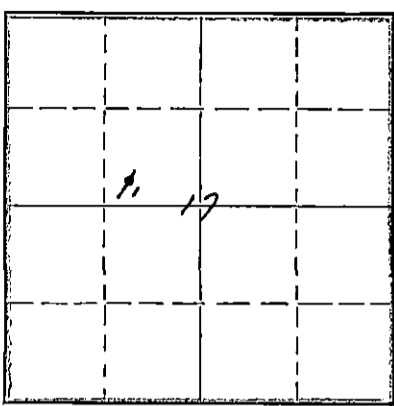

Locate well correctly on above
Section Plat

Meade County. Sec. 17 Twp. 34S Rge. 27 (E) 27 (W)
Location as "NE/CNW $\frac{1}{4}$ SW $\frac{1}{4}$ " or footage from lines SW $\frac{1}{4}$ SE $\frac{1}{4}$ NW $\frac{1}{4}$
Lease Owner Skelly Oil Company
Lease Name J. C. Tucker Well No. 1
Office Address Box 1650, Tulsa, Oklahoma
Character of Well (completed as Oil, Gas or Dry Hole) Dry Hole
Date well completed June 23, 19 51
Application for plugging filed June 25, 19 51
Application for plugging approved June 26, 19 51
Plugging commenced June 24, 19 51
Plugging completed June 24, 19 51
Reason for abandonment of well or producing formation Dry hole

If a producing well is abandoned, date of last production 19
Was permission obtained from the Conservation Division or its agents before plugging was commenced? Yes (verbally)

Name of Conservation Agent who supervised plugging of this well Mr. M. A. Rives 6430'
Producing formation Depth to top Bottom Total Depth of Well PB 6238 Feet
Show depth and thickness of all water, oil and gas formations.

OIL, GAS OR WATER RECORDS

CASING RECORD

Formation	Content	From	To	OD Size	Put In	Pulled Out
Mississippi Lime	Dry	5954'	5976'	13-3/8"	406'	None

Describe in detail the manner in which the well was plugged, indicating where the mud fluid was placed and the method or methods used in introducing it into the hole. If cement or other plugs were used, state the character of same and depth placed, from feet to feet for each plug set.

Stuck drill pipe 1660'
 35 sacks cement 1660' to 1545'
 Mud laden fluid 1545' to 540'
 45 sacks of cement 540' to 430'
 Mud laden fluid 430' to 20'
 20 sacks of cement 20' to 6'
 Surface soil 6' to 0'

(If additional description is necessary, use BACK of this sheet)

Correspondence regarding this well should be addressed to Skelly Oil Company
Address Box 391
Hutchinson, Kansas

STATE OF Kansas, COUNTY OF Reno, ss.
H. E. Wamsley (employee of owner) of the above-described well,
being first duly sworn on oath, says: That I have knowledge of the facts, statements, and matters herein contained and the log of the above-described well as filed and that the same are true and correct. So help me God.

(Signature) [Signature]
Box 391, Hutchinson, Kansas (Address)

SUBSCRIBED AND SWORN to before me this 17th day of July, 19 51.

My commission expires April 7, 1955

[Signature] Notary Public.


PLUGGING
FILE SEC 17 T 34 R 27 W
BOOK PAGE 99 LINE 39

23-3273-S 4-50-10M

JUL 19 1951
CONSERVATION DIVISION
Wichita, Kansas

a plugged hole drilled July, 1948, by White Eagle Oil Company, reopened by Skelly to test zone from 5954' to 5976', May, 1951.

SKELLY OIL COMPANY

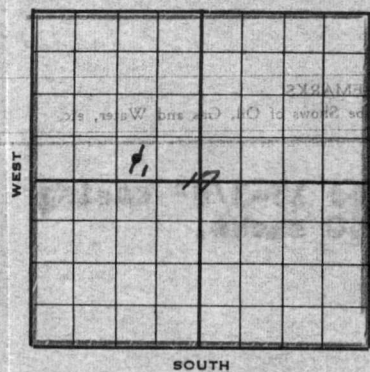

Well Record

Lease Name and No. J. C. Tucker Well No. 1 Elev. 2272'
 Lease Description 8240 acres in Township 34 South, Range 27 and 28 West, Noade County, Kansas
 Location made 19 by 990 feet from North line 330 feet from South line
11/4 feet from East line Sec. 17-34-27 feet from West line of

Work com'd 19 Rig comp'd 19 Drlg. com'd May 25, 1948 Drlg. comp'd July 12, 1948

Rig Contractor Nichols-Duncan Drig. Co.

Rotary Drilling from _____ to _____ Cable Tool Drilling from _____ to _____

Commenced Producing DRY HOLE 19 _____ Initial Prod. before shot or acid _____ Bbls.
 Initial Prod. after shot or acid _____ Bbls.

Dry Gas Well Press _____ Volume _____ Cu. ft.
 Casing Head Gas Pressure _____ Volume _____ Cu. ft.
 Braden Head (_____ Size) Gas Pressure _____ Volume _____ Cu. ft.
 Braden Head (_____ Size) Gas Pressure _____ Volume _____ Cu. ft.

PRODUCING FORMATION DRY HOLE (Name) Top _____ Bottom _____ TOTAL DEPTH 6430'
PB 6238'

CASING RECORD

OD Size	Wt.	Thds.	Where Set	PULLED OUT			LEFT IN			KIND	Cond'n	Sacks Used	CEMENTING Method Employed
				Jts.	Feet	In.	Jts.	Feet	In.				
<u>13-3/8"</u>			<u>405'</u>								<u>350</u>		
<u>(open hole perforated from 5954' to 5976' with 66 holes)</u>													
<u>PLUGGING</u>													
<u>PE 5954-5976</u>													

Liner Set at _____ Length _____ Perforated at _____
 Liner Set at _____ Length _____ Perforated at _____
 Packer Set at _____ Size and Kind _____
 Packer Set at _____ Size and Kind _____

SHOT OR ACID TREATMENT RECORD

	FIRST	SECOND	THIRD	FOURTH
Date	<u>6/3/51</u>	<u>6/6/51</u>		
Acid Used	<u>2000</u>	<u>1500</u>		
Size Shot	<u>5954</u>	<u>5976</u>	<u>5954</u>	<u>5976</u>
Shot Between	<u>5954</u> Ft. and <u>5976</u> Ft.	<u>5954</u> Ft. and <u>5976</u> Ft.		
Size of Shell				
Put in by (Co.)	<u>Dowell Inc.</u>	<u>Dowell Inc.</u>		
Length anchor	<u>Treatment in-</u>			
Distance below Cas'g	<u>complete</u>			
Damage to Casing or Casing Shoulder				

SIGNIFICANT GEOLOGICAL FORMATIONS

NAME	Top	Bottom	GAS		OIL		REMARKS
			From	To	From	To	
<u>Herrington</u>	<u>2487'</u>						
<u>Krieder</u>	<u>2585'</u>						
<u>Lansing Lias</u>	<u>4514'</u>						
<u>Morrow</u>	<u>5790'</u>						
<u>Mississippi Lias</u>	<u>5830'</u>						
<u>St. Genevieve</u>	<u>6266'</u>						

CLEANING OUT RECORDS

	DATE COMMENCED	DATE COMPLETED	PROD. BEFORE	PROD. AFTER	REMARKS
1st					See Reverse for other details.
2nd					" " " " "
3rd					" " " " "
4th					" " " " "

PLUGGING BACK AND DEEPENING RECORDS

	Date Commenced	Date Completed	No. Feet Plugged Back or Deepened	Prod. Before	Prod. After	REMARKS
1st						See Reverse for other details.
2nd						" " " " "
3rd						" " " " "
4th						" " " " "

(See Reverse for Record of Formation)

RECEIVED
 STATE CORPORATION COMMISSION
 JUL 19 1951
 DIVISION

15-119-00128-0001

RECORD OF FORMATIONS

FORMATION	Well Record	TOP	BOTTOM	REMARKS
Sand		0	70	
Red bed		70	490	Set and cemented 13-1/8" casing at 406' with 350 sacks.
Variegated shale and lime shells		490	1012	
Red bed and shells		1012	1240	
Anhydrite and shale		1240	1280	
Shale and shells		1280	1430	
Shale and shells		1430	2150	
Shale and anhydrite		2150	2506	TOP HERINGTON 2187'
Cherty dolomite		2506	2544	
Dolomite		2544	2744	TOP REEDER 2585'
Lime, broken		2744	2800	
Lime		2800	2830	
Lime and shale		2830	3082	
Lime		3082	3093	
Lime and shale		3093	3150	
Lime		3150	3182	
Cherty lime		3182	3196	
Lime and shale		3196	3360	
Lime		3360	3382	
Lime and shale		3382	3530	
Lime		3530	3600	
Lime and shale		3600	3808	
Lime		3808	3946	
Lime, shale streaks		3946	4040	
Lime and shale		4040	4384	
Lime		4384	4822	
Lime and shale		4822	4854	
Lime		4854	4912	
Lime and shale		4912	4940	
Lime		4940	5040	
Lime and shale		5040	5082	
Lime		5082	5670	
Shale and lime		5670	5697	
Lime		5697	5745	
Shale and lime		5745	5835	
Lime		5835	5876	
Lime and shale		5876	5915	
Lime		5915	6252	
Lime and shale		6252	6309	
Lime		6309	6332	
Lime and shale		6332	6430	

PLUGGING
 FILE SEC 17 T 34 R 27 W
 BOOK PAGE 90 LINE 39

TOP MORROW 5790'
TOP MISSISSIPPI LIMB 5830'

TOP ST. CATHARINE 6266'

SHOT OR ACID TREATMENT RECORD

Moved in and rigged up rotary tools of Nichols-Duncan Drilling Company. On May 17, drilled cement plug and cleaned out to 450'. Mixed mud and reconditioned hole and cleaned out to 6238'. On May 20, 1951, plugged back with 100 sacks of cement to 5005'. On May 22, washed out and reconditioned mud and drilled cement plug from 5005' to 6032' SLM.

On May 23, attempted to run Halliburton drill stem test with packer set at 5940'. Packer did not hold as anchor broke off at 5977' leaving one joint collar and one joint of pipe in hole. Tried to fish out drill pipe and collar, and could not recover.

On May 26, tried to run Halliburton drill stem test and packer would not set. Pulled drill pipe and tester. On May 27, ran drill pipe open and plugged back with 100 sacks of cement and 2 sacks of Cal-Seal. Rm'd drill pipe to 5890' and circulated out excess cement, pulled drill pipe and shut down for cement to set.

On May 29, drilled cement plug to 5902', reconditioned hole and ran Schlumberger Survey. On this date ran Halliburton drill stem test with packer set at 5856', open 1 hour and 25 mins. Slight blow for 35 minutes, recovered 90' of drilling mud, BHP-215'. Ran Halliburton drill stem test with packer set at 5840', open 90 minutes, recovered 210' of drilling mud, BHP-575'.

On May 31, drilled cement plug and cleaned out to 5990'. Circulated and cleaned up hole, then perforated with 66 holes. Reconditioned hole and ran 2 1/2" steel tubing on Johnson open hole packer with 50' of anchor. Set packer at 5940'. Rm'd 2 1/2" tubing, no shows. On June 3, tried to acidize through 2 1/2" tubing with 2000 gallons of Dowell "X" acid. Held 900 pressure through 17 hours and pumped 4 1/2 barrels of acid into formation. Sbabbed out acid and cleaned up hole, no shows of oil, gas, or water. On June 4, re-acidized through 2 1/2" tubing with 1500 gallons of Dowell "X" acid as follows:

REMARKS	Prod. After	Prod. Before	No. Feet Plugged	Date Completed	Date Commenced
See Reverse for other details					

RECEIVED
 STATE COMMISSION
 JUL 1 1951
 DIVISION

(See Reverse for Record of Formations)

MADE IN U.S.A.

ACID TREATMENT NO. 2 - Between 5954' and 5976'

Treatment put in 6/4/51 by Dowell Inc., using 1500 gallons of acid and 36 barrels of water to flush.

TIME	CP	TP	REMARKS
12:55 pm			1000 gallons of acid in tubing
12:57 pm			1500 gallons of acid in tubing
1:01 pm		375'	Start pump part time
1:28 pm		500'	Maintain 500 P.S.I.
2:45 pm		450'	Start flush
4:45 pm		400'	Reduce pressure on tubing
8:40 pm		350'	4 1/2 barrels of water in tubing to flush
9:05 pm		325'	6 1/2 barrels of water in tubing to flush
9:28 pm		350'	9 barrels of water in tubing to flush
10:08 pm		575'	12 barrels of water in tubing to flush
11:05 pm		575'	15 barrels of water in tubing to flush
1:00 am		400'	21 barrels of water in tubing to flush
2:30 am		425'	25 barrels of water in tubing to flush
5:15 am		450'	36 barrels of water used to flush and treatment completed

Swabbed out water used in treating, no shows of oil, gas, or water. Tried to pull 2 1/2" tubing and packer, packer would not move. Backed off of packer and pulled tubing. Fished out packer with drill pipe, then ran drill pipe open end to 5625' and plugged back with 100 sacks of cement. Raised drill pipe to 5390' and circulated out excess cement and pulled drill pipe. On June 7, drilled out streaks of cement from 5400' to 5495', cement plug did not set. On June 8, ran drill pipe open end and plugged back with 50 sacks of cement. Raised drill pipe to 5390' and circulated out excess cement.

On June 9, reconditioned hole and drilled cement plug to 5403'. Tried to run Halliburton drill stem test, packer would not set at 5359'. Pulled and reran tester, packer would not set at 5341'. Pulled tester, drilled cement plug and cleaned out to 5463'. Ran drill pipe open end to 5463' and plugged back with 100 sacks of cement. Raised drill pipe to 5380' and circulated out excess cement.

On June 11, reconditioned hole to 5389'. Tried to run Halliburton drill stem test with packer at 5357', packer would not set due to cavings in hole. Pulled tester, cleaned out cavings, and reconditioned hole. Tried to run drill stem test using 30' of anchor, anchor stopped at 5359'. Pulled tester, reconditioned hole and reran tester. Set packer at 5359', open 1 hour and 30 mins., recovered 270' of drilling mud, no oil, gas, or water, no BHP. Tried to run drill stem test with packer set at 5290'. Drill pipe stuck at 4129'. Ran McCullough Magna-Tector and found drill pipe stuck at 1680'. Attempted to circulate with 1300' pressure, could not circulate, unable to loosen pipe by working drill pipe. On June 16th, perforated drill pipe by McCullough with 6 holes at 3900' and gained circulation. Worked drill pipe 12 hours and pipe would not pull. Shot drill pipe at 1633' by McCullough and pulled drill pipe above that point. Ran in with Baash-Ross bumper sub, jarred on tools 6 hours, raised drill pipe 30" and pipe stuck.

On June 18, jarred and pulled on stuck drill pipe, but were unable to loosen pipe. Backed off drill pipe at 1633'. Ran in replacement drill pipe and took hold of stuck pipe with bumper sub. Jarred on drill pipe 8 hours, pipe would not move. Backed off of drill pipe at 1660'. Tried to take hold of drill collar side tracked in hole, could not get hold. Reran drill pipe with 7" OD wash over joint. Washed over stuck drill pipe to 1667', then ran in with top and took hold of drill collar lost in hold. Jarred on drill collar 12 hours, could not loosen. Lost hold on collar and at this time regular authority was granted to plug and abandon the well.

On June 24th, the well was plugged as follows:

35 sacks of cement	1660' to 1545'
Mud laden fluid	1545' to 540'
45 sacks of cement	540' to 430'
Mud laden fluid	430' to 20'
20 sacks of cement	20' to 6'
Surface soil	6' to 0'