

STATE OF KANSAS  
STATE CORPORATION COMMISSION


Give All Information Completely  
Make Required Affidavit  
Mail or Deliver Report to:  
Conservation Division  
State Corporation Commission  
211 No. Broadway  
Wichita, Kansas

WELL PLUGGING RECORD

Meade County, Sec. 13 Twp. 34S Rge. ----(E)27 (W)

Location as "NE/CNW/SW" or footage from lines 1250' ESL & 660' FWL SW/4  
Lease Owner Graham-Michaelis Drilling Company  
Lease Name Rierner Well No. 1-13  
Office Address 211 North Broadway, Wichita 2, Kansas  
Character of Well (completed as Oil, Gas or Dry Hole) GAS  
Date well completed May 17, 1961  
Application for plugging filed Sep. 17, 1963  
Application for plugging approved (Verbal) Sep. 4, 1963  
Plugging commenced Sep. 4, 1963  
Plugging completed Sep. 7, 1963  
Reason for abandonment of well or producing formation Non Commercial

NORTH

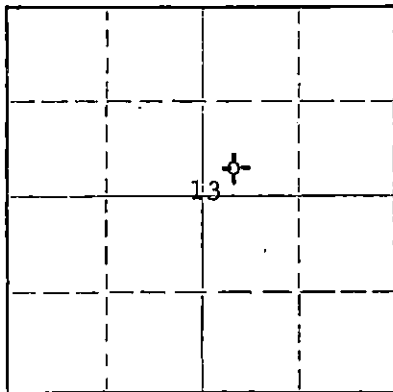

Locate well correctly on above  
Section Plat

If a producing well is abandoned, date of last production Jul. 31, 1963  
Was permission obtained from the Conservation Division or its agents before plugging was commenced? yes

Name of Conservation Agent who supervised plugging of this well Hugh Scott, Sublette, Kansas  
Producing formation Morrow Sand Depth to top 6015 Bottom 6030 Total Depth of Well 6215 Feet  
Show depth and thickness of all water, oil and gas formations.

OIL, GAS OR WATER RECORDS

CASING RECORD

FORMATION	CONTENT	FROM	TO	SIZE	PUT IN	PULLED OUT
Morrow Sand	GAS	6015	6030	8 5/8"	1327'	none
				4 1/2"	6214'	2809'

Describe in detail the manner in which the well was plugged, indicating where the mud fluid was placed and the method or methods used in introducing it into the hole. If cement or other plugs were used, state the character of same and depth placed, from \_\_\_\_\_ feet to \_\_\_\_\_ feet for each plug set.

Filled hole with heavy drilling mud from 1584' to bottom at 6215'. Pumped 15 sacks cement plug from 5804' to 5984'. Pumped 35 sacks cement plug from 600' to 700', and filled with heavy mud to 50'. Set rock bridge from 40' to 50', 15 sacks cement plug to surface. Cut off 8 5/8" pipe at base of cellar 3' below ground level. Welded 3/8" plate at top of 8 5/8" pipe.

**RECEIVED**  
STATE CORPORATION COMMISSION  
SEP 18 1963  
9-18-63  
CONSERVATION DIVISION  
Wichita, Kansas

(If additional description is necessary, use BACK of this sheet)

Name of Plugging Contractor Sargent Casing Pulling Company  
Address 121 W. 9th, Liberal, Kansas

STATE OF Kansas, COUNTY OF Sedgwick, ss.  
Jack L. Yinger (employee of owner) or (owner-or-operator) of the above-described well, being first duly sworn on oath, says: That I have knowledge of the facts, statements, and matters herein contained and the log of the above-described well as filed and that the same are true and correct. So help me God.

(Signature) Jack L. Yinger  
Jack L. Yinger - Geologist  
211 North Broadway, Wichita 2, Kansas  
(Address)

SUBSCRIBED AND SWORN TO before me this 17th day of September, 1963

Evelyn D. Evans  
Evelyn D. Evans  
Notary Public.

My commission expires December 12, 1966



RIEMER #1-13

## WELL RECORD:

## LOCATION:

Section 13-34S-27W  
Meade County, KansasCommenced: 4/20/61  
Completed: 5/11/61  
(Rotary)

## CONTRACTOR:

Graham-Michaelis Drilling Co.  
Liberal Division  
P. O. Box 896  
Liberal, Kansas

## CASING RECORD:

43 Jts. 8 5/8" 24# Casing  
Cemented w/500 sx Lite Weight  
and 250 sx Common 2% cc

	<u>LOG</u>
Red Bed & Soil	0 - 435
Red Bed	435 - 940
Shale, Sand & Gyp	940 - 1328
Red Bed & Shale	1328 - 1735
Shale & Gyp	1735 - 2374
Lime & Shale	2374 - 3450
Shale & Chalky Lime	3450 - 3956
Lime & Shale	3956 - 4271
Shale	4271 - 4440
Shale & Lime	4440 - 4947
Lime	4947 - 5172
Lime & Shale	5172 - 5277
Lime	5277 - 5333
Lime & Shale	5333 - 6012
Lime & Sand	6012 - 6035
Lime & Shale	6035 - 6215

**RECEIVED**  
STATE CORPORATION COMMISSION

SEP 18 1963

CONSERVATION DIVISION  
Wichita, Kansas6215' - Total Rotary Depth

The undersigned, Graham-Michaelis Drilling Company, Liberal Division, certifies that the above log is a true and correct copy of the formations encountered in drilling the above mentioned well, as taken from the Daily Drilling Report.

GRAHAM-MICHAELIS DRILLING COMPANY  
LIBERAL DIVISION

By

H. R. Michaelis