

STATE OF KANSAS  
STATE CORPORATION COMMISSION


WELL PLUGGING RECORD

Give All Information Completely  
Make Required Affidavit  
Mail or Deliver Report to:  
Conservation Division  
State Corporation Commission  
212 North Market, Insurance Bldg.  
Wichita, Kansas

Meade County, Sec. 13 Twp. 34S Rge. 27 (E) (W)

Location as "NE/CNW/SW" or footage from lines 1250' from south and east  
Lease Owner The Shamrock Oil and Gas Corporation  
Lease Name Cornelius F. Classen Well No. 1  
Office Address Box 631, Amarillo, Texas  
Character of Well (completed as Oil, Gas or Dry Hole) Dry  
Date well completed 9-21 19 60  
Application for plugging filed 9-21 19 60  
Application for plugging approved 9-21 19 60  
Plugging commenced 9-23 19 60  
Plugging completed 4:00 A.M. 9-23 19 60  
Reason for abandonment of well or producing formation Dry

NORTH

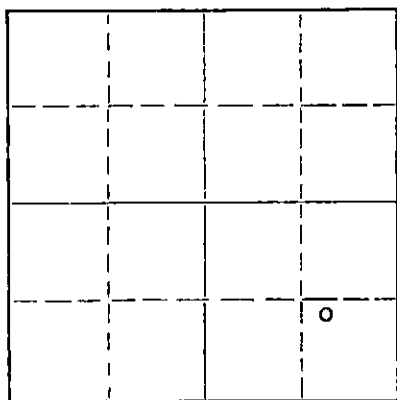

Locate well correctly on above  
Section Plat

If a producing well is abandoned, date of last production - 19  
Was permission obtained from the Conservation Division or its agents before plugging was commenced? Mr. W. L. Lackamp, Jr., State Engineer Yes

Name of Conservation Agent who supervised plugging of this well Mr. W. L. Lackamp, Jr., State Engineer  
Producing formation None Depth to top Bottom Total Depth of Well 6,230 Feet  
Show depth and thickness of all water, oil and gas formations.

OIL, GAS OR WATER RECORDS

CASING RECORD

FORMATION	CONTENT	FROM	TO	SIZE	PUT IN	PULLED OUT
None				8 5/8"	1,546'	-0-

Describe in detail the manner in which the well was plugged, indicating where the mud fluid was placed and the method or methods used in introducing it into the hole. If cement or other plugs were used, state the character of same and depth placed, from feet to feet for each plug set.

Filled hole with heavy mud to 1,480' and pushed Halliburton plug to 1,480'. Spotted 25 sacks cement on plug. Filled hole to 600' with heavy mud and pushed another plug to 600'. Spotted 25 sacks cement on plug. Filled hole to 30' and spotted 10 sacks cement to base of cellar.

RECEIVED  
STATE CORPORATION COMMISSION

SEP 28 1960 9-28-60

CONSERVATION DIVISION  
Wichita, Kansas

(If additional description is necessary, use BACK of this sheet)  
Name of Plugging Contractor Halliburton Oil Well Cementing Company  
Address Liberal, Kansas

STATE OF Texas, COUNTY OF Potter, ss.  
T. S. Clopton (employee of owner) or (owner/operator) of the above-described well, being first duly sworn on oath, says: That I have knowledge of the facts, statements, and matters herein contained and the log of the above-described well as filed and that the same are true and correct. So help me God.

(Signature) T. S. Clopton  
Box 631, Amarillo, Texas (Address)

SUBSCRIBED AND SWORN TO before me this 27th day of September, 19 60

My commission expires 6-1-61

PAULINE POWELL  
Notary Public  
Potter County, Texas  
Notary Public.

CORNELIUS F. CLASSEN NO. 1  
Section 13, Township 34 South, Range 27 West  
Meade County, Kansas

0'	-	450'	Surface sand and red bed
450'	-	695'	Sand and red bed
695'	-	1,623'	Red bed and shale
1,623'	-	2,350'	Shale and shells
2,350'	-	2,520'	Anhydrite
2,520'	-	2,609'	Anhydrite and lime
2,609'	-	2,720'	Anhydrite and shale
2,720'	-	2,831'	Anhydrite and lime
2,831'	-	3,061'	Lime and shale
3,061'	-	3,116'	Lime
3,116'	-	3,900'	Lime and shale streaks
3,900'	-	4,600'	Shale
4,600'	-	4,725'	Lime
4,725'	-	4,770'	Shale
4,770'	-	4,885'	Lime
4,885'	-	4,910'	Shale
4,910'	-	5,270'	Lime with shale streaks
5,270'	-	5,300'	Shale
5,300'	-	5,950'	Lime and shale
5,950'	-	6,230'	Lime

*J. S. Clayton*

RECEIVED  
STATE CORPORATION COMMISSION  
SEP 28 1960  
CORPORATION DIVISION