


STATE OF KANSAS
STATE CORPORATION COMMISSION
Give All Information Completely
Make Required Affidavit
Mail or Deliver Report to:
Conservation Division
State Corporation Commission
212 North Market, Insurance Bldg.
Wichita, Kansas

WELL PLUGGING RECORD

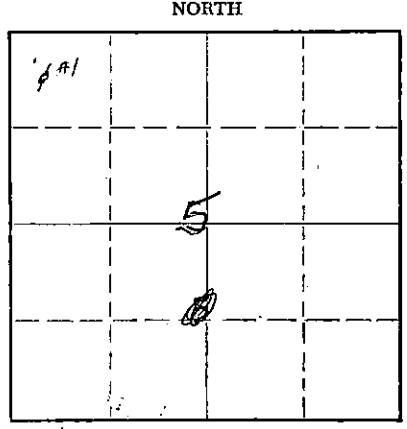

Clark County, Sec. 5 Twp. 34S Rge. 23W (E) W (W)
Location as "NE/CNW/SW" or footage from lines. 330' from North & West lines of NE/4
Lease Owner Sinclair Oil & Gas Co.
Lease Name I. J. Klinger Well No. 1
Office Address Box 521, Tulsa, Oklahoma
Character of Well (completed as Oil, Gas or Dry Hole) Dry Hole
Date well completed 6-24-60
Application for plugging filed 6-12-60
Application for plugging approved 6-12-60
Plugging commenced 6-22-60
Plugging completed 6-24-60
Reason for abandonment of well or producing formation Dry Hole

Locate well correctly on above Section Plat

If a producing well is abandoned, date of last production 19
Was permission obtained from the Conservation Division or its agents before plugging was commenced? Yes

Name of Conservation Agent who supervised plugging of this well Frank Broadfoot, St. Johns, Kansas
Producing formation None Depth to top Bottom Total Depth of Well 7243 Feet
Show depth and thickness of all water, oil and gas formations.

OIL, GAS OR WATER RECORDS CASING RECORD

FORMATION	CONTENT	FROM	TO	SIZE	PUT IN	PULLED OUT
No producing formations encountered				20"	50'	None
				13-3/8"	614'	None
				9-5/8"	2790'	1991'

Describe in detail the manner in which the well was plugged, indicating where the mud fluid was placed and the method or methods used in introducing it into the hole. If cement or other plugs were used, state the character of same and depth placed, from 2800' feet to surface feet for each plug set.

Hole was filled from TD 7243; ~~2800' to 2800'~~ 2800' - Set plug at 2800' Dumped sand to 2780' and dumped seven sacks cement on top of plug and sand - Shot off 9-5/8" casing at 1991' and pulled same. Mudded hole from 2766' to 300' with heavy drilling mud. Set rock bridge from 300' to 290' dumped 30 sacks cement to 230', mudded hole to 20' and set rock bridge to 10' and from 10' to surface with 10 sacks cement. COMPLETED PLUGGING at 4:PM 6-23-60.

RECEIVED
STATE CORPORATION COMMISSION
JUL 12 1960
7-12-60
CONSERVATION DIVISION
Wichita, Kansas

Name of Plugging Contractor Knight Casing Pulling Company
Address Chase, Kansas

STATE OF Kansas, COUNTY OF Rice, ss.
Virgil L. Johnson (employee of owner) or (owner or operator) of the above-described well, being first duly sworn on oath, says: That I have knowledge of the facts, statements and matters herein contained and the log of the above-described well as filed and that the same are true and correct. So help me God.

(Signature) Virgil L. Johnson
Box 466, Chase, Kansas (Address)

SUBSCRIBED AND SWORN TO before me this 11 day of July, 1960
L. B. Reynolds Notary Public.
My commission expires August 13, 1962

Re

I. J. KLINGER NO. 1

NE/4 of Section 5-34S-23W
Clark County, Kansas
Sinclair Oil & Gas Company

13-3/8" O. D. casing cemented at 614'
9-5/8" O. D. casing cemented at 2790'

Drilling commenced 4-21-60
Drilling completed 6-12-60

FROM	TO	FORMATION	REMARKS
0'	210'	Surface	
210	650	Red bed & shale	13-3/8" O. D. casing cemented with
650	900	Shale & lime	425 sacks at 614'
900	940	Anhydrite	
940	1200	Shale & shells	
1200	1510	Shale	
1510	1805	Shale & shells	
1805	1933	Shale & anhydrite	
1933	2075	Anhydrite & shale	
2075	2304	Anhydrite	
2304	2315	Lime & chert	
2315	2320	Anhydrite	
2320	2394	Shale & lime	
2394	2467	Lime & chert	
2467	2547	Lime & shale	
2547	2580	Shale & lime	
2580	2669	Lime	
2669	2744	Lime & shale	
2744	3075	Lime	9-5/8" O. D. casing cemented with
3075	3185	Lime & shale	200 sacks at 2790'
3185	3236	Lime	
3236	3343	Shale & lime	
3343	3580	Lime & shale	
3580	3648	Shale & lime	
3648	3704	Lime & shale	
3704	4173	Shale & lime	
4173	4282	Shale	
4282	4385	Shale & lime	
4385	4595	Lime	
4595	4655	Lime & chalk	
4655	4700	Lime & shale	
4700	4870	Lime	
4870	4932	Lime & chert	
4932	5023	Lime & shale	
5023	5123	Lime	
5123	5156	Lime & chert	

RECEIVED
STATE CORPORATION COMMISSION
JUL 13 1960
CORPORATION DIVISION
Topeka, Kansas

6

FROM	TO	FORMATION	REMARKS
5156'	5190'	Lime	
5190	5224	Lime & chert	
5224	5450	Lime	
5450	5502	Lime & shale	
5502	5555	Lime	
5555	5563	Chalky lime	
5563	5793	Lime	
5793	5911	Lime & chert	
5911	5934	Lime	
5934	5994	Lime & chert	
5994	6219	Lime	
6219	6328	Lime & chalk	
6328	6404	Lime	
6404	6418	Lime & chert	
6418	6456	Lime	
6456	6492	Lime & chert	
6492	6517	Lime	
6517	6575	Lime & chert	
6575	6863	Lime	
6863	6882	Lime & shale	
6882	6913	Lime & chalk	
6913	6992	Lime	
6992	7005	Dolomite & chert	
7005	7016	Lime & chalk	
7016	7041	Lime & chert	
7041	7078	Lime & shale	
7078	7088	Sand & shale	
7088	7107	Sand	
7107	7120	Shale & sand	
7120	7243	Lime	DRY HOLE

T. D. 7243'

RECEIVED
STATE CORPORATION COMMISSION

JUL 13 1960

CONSERVATION DIVISION
Wichita, Kansas

This is a true copy of the driller's log as shown on the drilling tickets.

BARBOUR DRILLING COMPANY

By *C. W. Dribel*

Subscribed and sworn to before me on this 27th day of June, 1960

Mary Jane Burt
Notary Public

My commission expires July 27, 1961