


STATE OF KANSAS  
STATE CORPORATION COMMISSION

WELL PLUGGING RECORD

Give All Information Completely  
Make Required Affidavit  
Mail or Deliver Report to:  
Conservation Division  
State Corporation Commission  
211 No. Broadway  
Wichita, Kansas

Clark County. Sec. 36 Twp. 34S Rge. (E) 22(W)  
Location as "NE/CNWxSWx" or footage from lines C SE 1/4 SE 1/4  
Lease Owner Falcon Seaboard Drilling Co.,  
Lease Name Randall Well No. 2  
Office Address Pan American Bldg. Tulsa, Oklahoma.  
Character of Well (completed as Oil, Gas or Dry Hole) Dry Hole  
Date well completed August 10th 19 60  
Application for plugging filed August 10th 19 60  
Application for plugging approved August 10th 19 60  
Plugging commenced 3 P. M. August 10th 19 60  
Plugging completed 9 P. M. August 10th 19 60  
Reason for abandonment of well or producing formation \_\_\_\_\_

NORTH

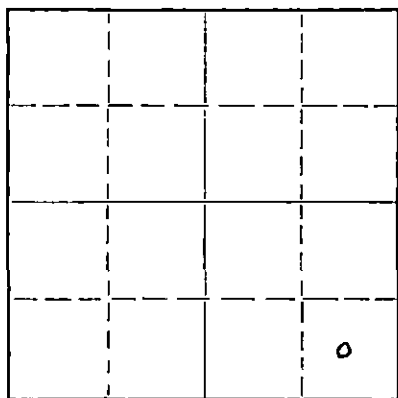

Locate well correctly on above  
Section Plot

If a producing well is abandoned, date of last production \_\_\_\_\_ 19 \_\_\_\_  
Was permission obtained from the Conservation Division or its agents before plugging was commenced? Yes

Name of Conservation Agent who supervised plugging of this well J. L. Brock  
Producing formation \_\_\_\_\_ Depth to top \_\_\_\_\_ Bottom \_\_\_\_\_ Total Depth of Well 5852 Feet  
Show depth and thickness of all water, oil and gas formations.

OIL, GAS OR WATER RECORDS

CASING RECORD

FORMATION	CONTENT	FROM	TO	SIZE	PUT IN	PULLED OUT
				13 3/8	225'	None
				7"	2600'	None

Describe in detail the manner in which the well was plugged, indicating where the mud fluid was placed and the method or methods used in introducing it into the hole. If cement or other plugs were used, state the character of same and depth placed, from \_\_\_\_\_ feet to \_\_\_\_\_ feet for each plug set.

In Hole open end to 2650 feet 30 Sacks Cement with Halliburton fill up to 2488 feet, Bridge plug at 90 feet, 20 sacks cement to bottom of cellar.

RECEIVED  
STATE CORPORATION COMMISSION

AUG 22 1960

CONSERVATION DIVISION  
Wichita, Kansas

(If additional description is necessary, use BACK of this sheet)

Name of Plugging Contractor Patton Drilling Company, Inc.  
Address 505 Orpheum Bldg. Wichita 2, Kansas.

STATE OF Kansas, COUNTY OF Sedgwick, ss.  
R. C. Patton (employee of owner) or (~~owner or operator~~) of the above-described well, being first duly sworn on oath, says: That I have knowledge of the facts, statements, and matters herein contained and the log of the above-described well as filed and that the same are true and correct. So help me God. Patton Drilling Co., Inc.  
(Signature) By R. C. Patton  
505 Orpheum Bldg. Wichita 2, Kansas  
(Address)

SUBSCRIBED AND SWORN to before me this 17th day of August, 19 60

My commission expires October 4th 1960 T. P. Hendrick Notary Public.

