

STATE OF KANSAS
STATE CORPORATION COMMISSION

Give All Information Completely
Make Required Affidavit
Mail or Deliver Report to:
Conservation Division
State Corporation Commission
211 No. Broadway
Wichita, Kansas

WELL PLUGGING RECORD

Clark County, Sec. 26 Twp. 34S Rge. (E) 22 (W)

Location as "NE/CNW%SW%" or footage from lines C NE/4

Lease Owner Graham-Michaelis Drilling Company

Lease Name Randall Well No. 2-26

Office Address 211 No. Broadway, Wichita, Kansas 67202

Character of Well (completed as Oil, Gas or Dry Hole) Dry Hole

Date well completed Feb. 18, 1964

Application for plugging filed verbal Feb. 18, 1964

Application for plugging approved verbal Feb. 18, 1964


Plugging commenced Feb. 18, 1964

Plugging completed Feb. 18, 1964

Reason for abandonment of well or producing formation Dry Hole

If a producing well is abandoned, date of last production 19

Was permission obtained from the Conservation Division or its agents before plugging was commenced? yes - verbal

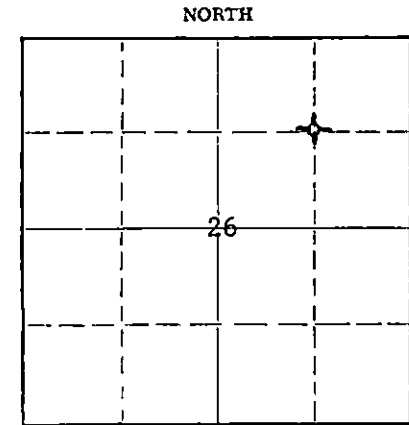

Locate well correctly on above Section Flat

Name of Conservation Agent who supervised plugging of this well Hugh E. Scott, Liberal, Kansas

Producing formation none Depth to top Bottom Total Depth of Well 5641' Feet

Show depth and thickness of all water, oil and gas formations.

OIL, GAS OR WATER RECORDS

CASING RECORD

FORMATION	CONTENT	FROM	TO	SIZE	PUT IN	PULLED OUT
				8 5/8"	644'	none

Describe in detail the manner in which the well was plugged, indicating where the mud fluid was placed and the method or methods used in introducing it into the hole. If cement or other plugs were used, state the character of same and depth placed, from feet to feet for each plug set.

Filled hole with heavy drilling mud, cement plug at 620' with 35 sx cement.
Filled hole with heavy drilling mud to 40' and cement plug at 40' with 15 sx cement. Cement plug at surface.

RECEIVED
STATE CORPORATION COMMISSION

FEB 25 1964

CONSERVATION DIVISION
Wichita, Kansas

(If additional description is necessary, use BACK of this sheet)

Name of Plugging Contractor Graham-Michaelis Drilling Company

Address 211 North Broadway, Wichita, Kansas

STATE OF Kansas, COUNTY OF Sedgwick, ss.

Jack L. Yinger (employee of owner) or (owner or operator) of the above-described well, being first duly sworn on oath, says: That I have knowledge of the facts, statements, and matters herein contained and the log of the above-described well as filed and that the same are true and correct. So help me God.

(Signature) Jack L. Yinger - Geologist
211 North Broadway, Wichita, Kansas
(Address)

SUBSCRIBED AND SWORN TO before me this 19th day of February, 1964

Evelyn D. Evans
Evelyn D. Evans Notary Public.

My commission expires Dec. 12, 1966

RANDALL #2-26

WELL RECORD:

LOCATION:

C NE/4, Section 26-34S-22W
Clark County, Kansas

Commenced: 2-3-64
Completed: 2-18-64
(Rotary)

CONTRACTOR:

Graham-Michaelis Drilling Co.
Liberal Division
P. O. Box 1294
Liberal, Kansas

CASING RECORD:

20 Joints 8-5/8" Casing
Cemented w/250 sx Sunset
Cemented f/top w/3 sx Hulls,
50 sx Sunset w/5 sx Hulls,
wait 45 min. f/bridge to set
and Cement w/50 sx Sunset

	<u>LOG</u>	
Red Bed & Sand	0 -	624
Red Bed & Gyp	624 -	770
Shale	770 -	2258
Lime	2258 -	2368
Lime & Shale	2368 -	2611
Lime	2611 -	2761
Lime & Shale	2761 -	3711
Lime	3711 -	3751
Lime & Shale	3751 -	4988
Lime	4988 -	5114
Lime & Shale	5114 -	5536
Lime, Shale & Sand	5536 -	5560
Lime & Shale	5560 -	5623
Lime	5623 -	5639

RECEIVED
STATE CORPORATION COMMISSION

FEB 25 1964

CONSERVATION DIVISION
Wichita, Kansas

5639' - Total Rotary Depth

The undersigned, Graham-Michaelis Drilling Company, Liberal Division, certifies that the above log is a true and correct copy of the formations encountered in drilling the above mentioned well, as taken from the Daily Drilling Report.

GRAHAM-MICHAELIS DRILLING COMPANY
LIBERAL DIVISION

By J. A. [Signature]