

Give All Information Completely  
Make Required Affidavit  
Mail or Deliver Report to:  
Conservation Division  
State Corporation Commission  
211 No. Broadway  
Wichita, Kansas

### WELL PLUGGING RECORD

Clark County, Sec. 26 Twp. 34S Rge. 22W (E) (W)

Location as "NE/CNW/SW" or footage from lines C-SE/4

Lease Owner Graham-Michaelis Drilling Co.

Lease Name Randall Well No. L-26

Office Address Box 1294 Liberal, Kansas

Character of Well (completed as Oil, Gas or Dry Hole) Oil

Date well completed Nov. 11, 1963 19 63

Application for plugging filed 3-16-9 19 65

Application for plugging approved 3-18-12 19 65


Plugging commenced 3-19 19 65

Plugging completed 3-21 19 65

Reason for abandonment of well or producing formation went to water

If a producing well is abandoned, date of last production November, 19 64

Was permission obtained from the Conservation Division or its agents before plugging was commenced? Yes

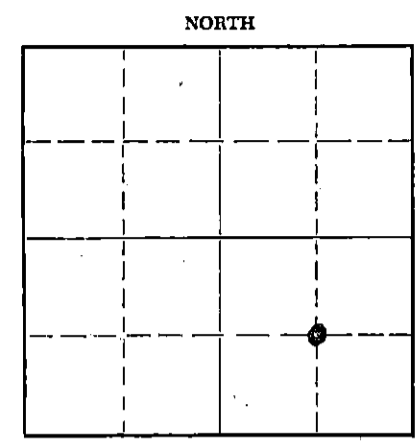

Locate well correctly on above Section Plat

Name of Conservation Agent who supervised plugging of this well High Scott

Producing formation Morrow Sand Depth to top 5534 Bottom 5572 Total Depth of Well 5724 Feet

Show depth and thickness of all water, oil and gas formations.

#### OIL, GAS OR WATER RECORDS

#### CASING RECORD

FORMATION	CONTENT	FROM	TO	SIZE	PUT IN	PULLED OUT
Morrow Sand	oil	5532	5578	8 5/8	750	none
				4 1/2	5723	2840

Describe in detail the manner in which the well was plugged, indicating where the mud fluid was placed and the method or methods used in introducing it into the hole. If cement or other plugs were used, state the character of same and depth placed, from \_\_\_\_\_ feet to \_\_\_\_\_ feet for each plug set.

Mix 20 sacks cement to plug off perforations at 5534. Stop plug at 5350 feet. Pull 2840 feet of 4 1/2" casing. spot 35 sacks cement at 700 feet with pump truck through 4 1/2" casing. put 15 sacks cement from 45 feet to 0'. Cut off and cap 3 feet below ground level.

RECEIVED  
STATE CORPORATION COMMISSION

APR 5 1965  
4-5-65

CONSERVATION DIVISION  
Wichita, Kansas

(If additional description is necessary, use BACK of this sheet)

Name of Plugging Contractor Sargents Casing Pulling Service

Address Box 506 Liberal, Kansas

STATE OF KANSAS, COUNTY OF SEDGWICK, ss.  
Jack L. Yinger (employee of owner) or (owner or operator) of the above-described well, being first duly sworn on oath, says: That I have knowledge of the facts, statements, and matters herein contained and the log of the above-described well as filed and that the same are true and correct. So help me God.

(Signature) Jack L. Yinger  
211 North Broadway, Wichita, Kansas  
(Address)

SUBSCRIBED AND SWORN TO before me this 2nd day of April, 19 65

Evelyn D. Evans  
Evelyn D. Evans Notary Public.

My commission expires December 12, 1966



RANDALL #1-26

WELL RECORD:

LOCATION:

C SE/4 Section 26-34-22  
Clark County, Kansas

Commenced: 9-17-63  
Completed: 10-3-63  
(Rotary)

CONTRACTOR:

Graham-Michaelis Drilling Co.  
Liberal Division  
P. O. Box 1294  
Liberal, Kansas

CASING RECORD:

24 Joints 8-5/8" 24# Casing  
Cemented w/250 sx Sunset, 7 sx  
Hulls, 3 yds Rock followed w/200  
sx Sunset

	<u>LOG</u>	
Shale	0 -	110
Sand & Gyp	110 -	750
Shale	750 -	830
Shale & Anhy	830 -	1285
Shale	1285 -	2223
Shale & Anhy	2223 -	2361
Lime & Shale	2361 -	4694
Lime	4694 -	4791
Lime & Shale	4791 -	4968
Lime	4968 -	5456
Lime & Sand	5456 -	5550
Lime	5550 -	5729

5729' - Total Rotary Depth

The undersigned, Graham-Michaelis Drilling Company, Liberal Division, certifies that the above log is a true and correct copy of the formations encountered in drilling the above mentioned well, as taken from the Daily Drilling Report.

GRAHAM-MICHAELIS DRILLING COMPANY  
LIBERAL DIVISION

By H. R. Michaelis  
H. R. Michaelis

**RECEIVED**  
STATE CORPORATION COMMISSION

APR 5 1965

CONSERVATION DIVISION  
Wichita, Kansas