


STATE OF KANSAS
STATE CORPORATION COMMISSION

WELL PLUGGING RECORD

Give All Information Completely
Make Required Affidavit
Mail or Deliver Report to
Conservation Division
State Corporation Comm.
245 North Water
Wichita, KS 67202

Clark County, Sec. 25 Twp. 34S Rge. 22W E/W
Location as "NE/CNW $\frac{1}{4}$ SW $\frac{1}{4}$ " or footage from lines
NW SE NE

Lease Owner Beren Corporation
Lease Name Randall A Well No. 1
Office Address 970 Fourth Financial Center, Wichita, KS 67202
Character of Well (Completed as Oil, Gas or Dry Hole)
dry hole

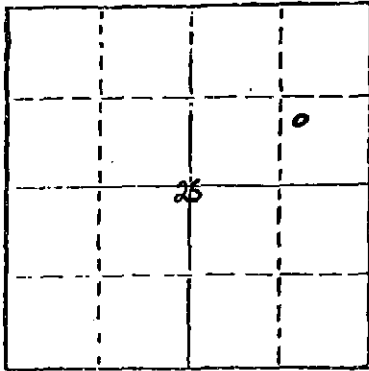

Locate well correctly on above
Section Plat

Date Well completed 1/17/81 19
Application for plugging filed 1/17/81 19
Application for plugging approved 1/17/81 19
Plugging commenced 1/17/81 19
Plugging completed 1/17/81 19
Reason for abandonment of well or producing formation
dry hole

If a producing well is abandoned, date of last production
19

Was permission obtained from the Conservation Division or
its agents before plugging was commenced? yes
Clarence Thomas

Name of Conservation Agent who supervised plugging of this well
Producing formation Depth to top Bottom Total Depth of Well 5720'
Show depth and thickness of all water, oil and gas formations.

OIL, GAS OR WATER RECORDS

CASING RECORD

FORMATION	CONTENT	FROM	TO	SIZE	PUT IN	PULLED OUT

Describe in detail the manner in which the well was plugged, indicating where the mud fluid was placed and the method or methods used in introducing it into the hold. If cement or other plugs were used, state the character of same and depth placed, from feet to feet for each plug set.

Hole plugged with 60-40 pozmix, as follows:
60 sacks @ 880', 25 sacks @ 400', 10 sacks @ 40', 5 sacks rathole.
Plugging completed 10:15 AM, January 17, 1981

(If additional description is necessary, use BACK of this sheet)

Name of Plugging Contractor BEREDCO INC.

STATE OF Kansas COUNTY OF Sedgwick, ss.
J. D. Marcus (employee of owner) or (owner or operator)
of the above-described well, being first duly sworn on oath, says: That I have knowledge of the facts, statements, and matters herein contained and the log of the above-described well as filed and that the same are true and correct. So help me God.

(Signature) *J. D. Marcus*
970 Fourth Financial Center, Wichita, KS 67202
(Address)

SUBSCRIBED AND SWORN TO before me this 10th day of March 19 81



My commission expires 4/27/81

Marca J. Dearth
Notary Public.
MAR 13 1981

CONSERVATION DIVISION
Wichita, Kansas

DRILLERS LOG

Randall A-1

Clark County
NW SE NE
Sec. 25-34S-22W

Company: BEREN CORPORATION

Contractor: BEREDCO INC.

Comm: January 1, 1981

Comp.: January 17, 1981

Casing: 8 5/8", 24# set at 865' with 475 sacks Hol-lite, 3% CC, 2% gel.
dry hole

<u>FORMATION</u>	<u>FROM</u>	<u>TO</u>
Cemt & RB	0'	168'
Red Bed	168'	876'
RB & Shale	876'	1779'
Lime & Shale	1779'	5598'
Lime	5598'	5720'

RECEIVED
STATE CORPORATION COMMISSION
MAR 13 1981
CONSERVATION DIVISION
Wichita, Kansas

Rotary Total Depth - 5720'


STATE OF KANSAS

SS:

COUNTY OF SEDGWICK

I certify that this is a true and correct copy of the above log as shown by the drilling reports.

BEREDCO

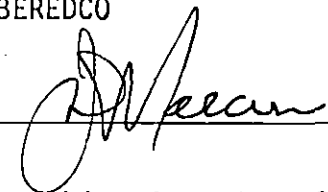

Subscribed and sworn to before me this 10 day of March, 1981



