


STATE OF KANSAS
STATE CORPORATION COMMISSION
Give All Information Completely
Make Required Affidavit
Mail or Deliver Report to:
Conservation Division
State Corporation Commission
212 North Market, Insurance Bldg.
Wichita, Kansas

WELL PLUGGING RECORD

Meade County, Sec. 35 Twp. 33S Rge. (E) 29 (W)

Location as "NE/CNW/SW" or footage from lines 330' from North and East lines
Lease Owner The Shamrock Oil and Gas Corporation
Lease Name Lola K. Hilst Well No. 1
Office Address Box 631, Amarillo, Texas
Character of Well (completed as Oil, Gas or Dry Hole) Oil
Date well completed September 26, 1958
Application for plugging filed December 4, 1966
Application for plugging approved December 4, 1966
Plugging commenced December 4, 1966
Plugging completed December 7, 1966
Reason for abandonment of well or producing formation No longer capable of commercial production
If a producing well is abandoned, date of last production April 1965
Was permission obtained from the Conservation Division or its agents before plugging was commenced? Yes

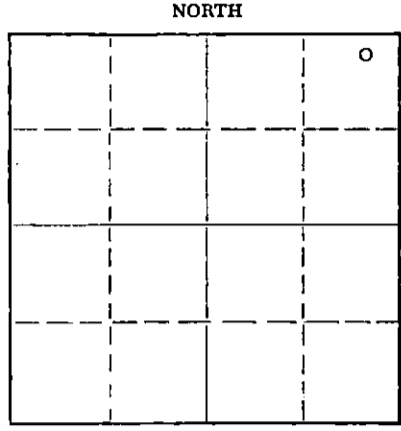

Locate well correctly on above Section Plat

Name of Conservation Agent who supervised plugging of this well Mr. Edgar J. Eves
Producing formation Morrow Depth to top 5692 Bottom 5714 Total Depth of Well 5821 Feet
Show depth and thickness of all water, oil and gas formations.

OIL, GAS OR WATER RECORDS

CASING RECORD

FORMATION	CONTENT	FROM	TO	SIZE	PUT IN	PULLED OUT
Morrow	Oil	5,692	5,714	9 5/8"	1,547.84	-0-
				5 1/2"	5,821.00	

Describe in detail the manner in which the well was plugged, indicating where the mud fluid was placed and the method or methods used in introducing it into the hole. If cement or other plugs were used, state the character of same and depth placed, from _____ feet to _____ feet for each plug set.

Filled casing with mud. Shot 5 1/2" casing at 3,489' - 3,021' - 2,794' - 2,608'. Casing came loose. Spotted 40-sack plug from 1,591' to 1,491'. Displaced with 36.5 barrels of mud. Recovered 81 joints, or 2,650.90' of 5 1/2" casing. Spotted 10 sacks cement from 30' to 5'. Welded plate on top of surface casing. Completed at 1:30 P.M., 12-7-66.

DEC 12 1966
12-12-66
CONSERVATION DIVISION
Wichita, Kansas

Mr. Eves with Corporation Commission witnessed pumping of plug.

(If additional description is necessary, use BACK of this sheet)

Name of Plugging Contractor Daco Well Service
Address 1700 S. Main, Borger, Texas

STATE OF Texas COUNTY OF Potter ss.
W. W. Killingsworth, Jr. (employee of owner) or (owner or operator) of the above-described well, being first duly sworn on oath, says: That I have knowledge of the facts, statements, and matters herein contained and the log of the above-described well as filed and that the same are true and correct. So help me God.

(Signature) W. W. Killingsworth, Jr.
Box 631, Amarillo, Texas (Address)

SUBSCRIBED AND SWORN TO before me this 9th day of December, 1966
Pauline Powell Notary Public
Potter County, Texas Notary Public.

My commission expires 6-1-67



330' FNL Sec. 35-33S-29W
330' FEL Meade County, Kansas

LILA K. HILST NO. 1

- 0 - 200' Red Bed and sand
- 200 - 555' Sand, shale, lime
- 555 - 745' Shale and shells
- 745 - 1,045' Sand and shale
- 1,045 - 1,202' Shale, Red bed and sand
- 1,202 - 1,435' Shale and Red bed
- 1,435 - 1,540' Sand and shale
- 1,540 - 2,365' Shale and shells
- 2,365 - 2,486' Lime and shale
- 2,486 - 2,515' Lime
- 2,515 - 2,840' Lime and shale
- 2,840 - 2,907' Anhydrite and shale
- 2,907 - 2,950' Shale and anhydrite
- 2,950 - 3,191' Anhydrite
- 3,191 - 3,374' Lime and shale
- 3,374 - 4,615' Shale and lime
- 4,615 - 4,705' Lime
- 4,705 - 4,796' Lime and shale
- 4,796 - 5,726' Lime
- 5,726 - 5,751' Sand
- 5,751 - 5,803' Lime and shale
- 5,803 - 5,821' Lime

RECEIVED
STATE CORPORATION COMMISSION

DEC 6 1966

CONSERVATION DIVISION
Wichita, Kansas