

STATE OF KANSAS  
STATE CORPORATION COMMISSION

WELL PLUGGING RECORD

Give All Information Completely  
Make Required Affidavit  
Mail or Deliver Report to:  
Conservation Division  
State Corporation Commission  
211 No. Broadway  
Wichita, Kansas

Meade

County. Sec. 35 Twp. 33S Rge. 29 (E) (W)

Location as "NE/CNW/SW" or footage from lines 2310' fr. N. & 630' fr. West

Lease Owner The Shamrock Oil and Gas Corporation

Lease Name Irvin Vogt et ux

Well No. 1

Office Address Box 631, Amarillo, Texas

Character of Well (completed as Oil, Gas or Dry Hole) Dry Hole

Date well completed 10-9 19 58

Application for plugging filed 10-9 19 58

Application for plugging approved 10-9 19 58


Plugging commenced 10-9 19 58

Plugging completed 10-9 19 58

Reason for abandonment of well or producing formation Dry

If a producing well is abandoned, date of last production 19

Was permission obtained from the Conservation Division or its agents before plugging was commenced? Yes

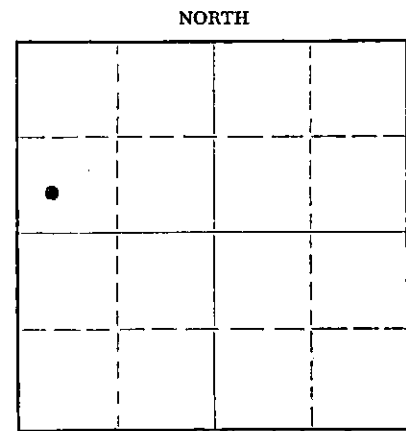

Locate well correctly on above Section Plat

Name of Conservation Agent who supervised plugging of this well Merle Rives

Producing formation None Depth to top --- Bottom --- Total Depth of Well 5,885 Feet

Show depth and thickness of all water, oil and gas formations.

OIL, GAS OR WATER RECORDS

CASING RECORD

FORMATION	CONTENT	FROM	TO	SIZE	PUT IN	PULLED OUT
Sand, gravel, & sands	Water sands	0	500	9 5/8"	1542.28	-0-

Describe in detail the manner in which the well was plugged, indicating where the mud fluid was placed and the method or methods used in introducing it into the hole. If cement or other plugs were used, state the character of same and depth placed, from \_\_\_\_\_ feet to \_\_\_\_\_ feet for each plug set.

Pushed 9 5/8" OD Halliburton plug to 900' with 1 sack of hulls ahead of plug. Spotted 20 sacks cement at 900'. Filled hole with heavy rotary mud. Pushed 9 5/8" OD Halliburton plug to 300' with 1 sack hulls ahead of plug. Spotted 20 sacks cement at 300'. Filled hole with heavy rotary mud. Pushed 9 5/8" OD Halliburton plug to 35'. Filled hole to base of cellar with 15 sacks cement.

(If additional description is necessary, use BACK of this sheet)

Name of Plugging Contractor Halliburton Oil Well Cementing Company

Address Great Bend, Kansas

STATE OF Texas, COUNTY OF Potter, ss.  
T. S. Clopton

(employee of owner) or (owner/operater) of the above-described well, being first duly sworn on oath, says: That I have knowledge of the facts, statements, and matters herein contained and the log of the above-described well as filed and that the same are true and correct. So help me God.

(Signature) T. S. Clopton

Box 631, Amarillo, Texas

(Address)

SUBSCRIBED AND SWORN TO before me this 14th

day of October

19 58

PAULINE POWELL  
Notary Public

Potter County, Texas

(Notary Public)

My commission expires 6-1-59

RECEIVED  
STATE CORPORATION COMMISSION  
10-15-58  
OCT 15 1958

PLUGGING  
FILE SEC. 35 T. 33 R. 29W  
BOOK PAGE 136 LINE 32

C → Shamrock Oil Gas  
Curtis → D + M only

IRVIN VOGT NO. 1  
Section 35, T33S, R29W, Meade Co.  
Kansas

SW SW NW

0' - 500'	Sand and shale
500' - 750'	Red bed, sand, & shale
750' - 910'	Shale & shells
910' - 1,175'	Sand & shale
1,175' - 1,235'	Shale, shells, & red beds
1,235' - 2,025'	Shale & shells
2,025' - 4,475'	Shale & lime
4,475' - 4,480'	Shale
4,480' - 4,535'	Lime
4,535' - 4,550'	Shale
4,550' - 5,140'	Lime
5,140' - 5,150'	Shale
5,150' - 5,350'	Lime
5,350' - 5,370'	Shale
5,370' - 5,425'	Lime
5,425' - 5,430'	Shale
5,430' - 5,466'	Lime
5,466' - 5,470'	Shale
5,470' - 5,575'	Lime
5,575' - 5,580'	Shale
5,580' - 5,640'	Lime
5,640' - 5,660'	Shale & limey shale
5,660' - 5,704'	Lime
5,704' - 5,770'	Sand
5,770' - 5,875'	Lime
5,875' - 5,885'	Shale

**PLUGGING**  
 FILE SEC. 35 T. 33 R. 29W  
 BOOK PAGE 136 LINE 32