

RECEIVED  
STATE CORPORATION COMMISSION

STATE OF KANSAS  
STATE CORPORATION COMMISSION

Give All Information Completely  
Make Required Affidavit  
Mail or Deliver Report to  
Conservation Division  
State Corporation Comm.  
245 North Water  
Wichita, KS 67202

WELL PLUGGING RECORD  
Meade County, Kansas Twp. 33 Rge. 30 E/W

CONSERVATION DIVISION  
Wichita, Kansas

DEC 17 1981

Location as "NE/CNW $\frac{1}{2}$ SW $\frac{1}{2}$ " or footage from lines  
940' FWL & 2565' FNL

Lease Owner Calvin Exploration Inc.

Lease Name Novinger Well No. 1-25

Office Address Box 6, Liberal, Ks. 67901

Character of Well (Completed as Oil, Gas or Dry Hole)  
Gas Well

✓ Date Well completed 9-16-80 19

Application for plugging filed 6-18-81 19

Application for plugging approved 6-30-81 19

Plugging commenced 12-7-81 19

Plugging completed 12-10-81 19

Reason for abandonment of well or producing formation  
Non Commercial Value


If a producing well is abandoned, date of last production  
None 19

Was permission obtained from the Conservation Division or  
its agents before plugging was commenced? yes

Name of Conservation Agent who supervised plugging of this well Mr. Luthi

Producing formation Narrow Depth to top 5796 Bottom 5804 Total Depth of Well 5915

Show depth and thickness of all water, oil and gas formations.

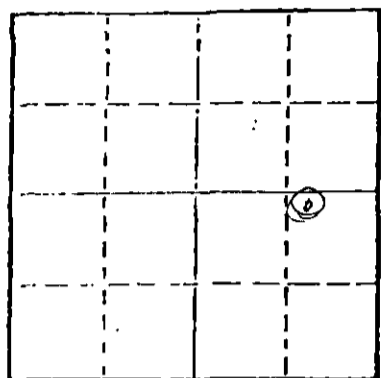

Locate well correctly on above  
Section Plot

OIL, GAS OR WATER RECORDS

CASING RECORD

FORMATION	CONTENT	FROM	TO	SIZE	PUT IN	PULLED OUT
Surface				8 5/8"	1518	0
Production				4 1/2"	5915	3220

Describe in detail the manner in which the well was plugged, indicating where the mud fluid was placed and the method or methods used in introducing it into the hold. If cement or other plugs were used, state the character of same and depth placed, from \_\_\_\_\_ feet to \_\_\_\_\_ feet for each plug set.

Pumped 1 sk. hulls & 15 sks. cement to 5650' Pressured to 750 lbs.

Displaced w/mud to 1500'

Pumped 35 sks. cement 1500' to 1400'

Displaced w/mud to 40'

Put bridge & 10 sks. cement 50' to 0'

Cut off 8 5/8", 42' below ground level

(If additional description is necessary, use BACK of this sheet)

Name of Plugging Contractor Midwest Casing Pulling Service

Permit #766

STATE OF KANSAS COUNTY OF HASKELL, ss.  
I, Edgar J. Eves (employee of owner) or (owner or operator)

of the above-described well, being first duly sworn on oath, says: That I have knowledge of the facts, statements, and matters herein contained and the log of the above-described well as filed and that the same are true and correct. So help me God.

(Signature) Edgar J. Eves  
Box F, Sublette, Ks.

(Address)

SUBSCRIBED AND SWORN TO before me this 14th day of Dec., 1981

Sondra L. Eves  
Notary Public.

My commission expires 12-6-84



DRILLER'S LOG

Calvin Exploration, Inc.  
1125 17th Street  
Suite 2000  
Denver, Colorado 80202

Total Depth: 5980 feet

Mohler #1  
Section 35-33S-29W.  
Meade County, Kansas

Surface Casing: Drilled 1409' of 12 1/4 hole.  
Ran 35jnts. of new 23#, 8 5/8", total 1409.81.  
Set at 1406 K.B. Cemented with 550 sks. 65-35 poz  
with 1/4# D-29 per sk. with 2% CC, tailed with  
200 sks. class H with 3% CC. Dowell cemented  
plug held, cement circ., Plug down at 11:pm  
12-12-81

Commenced: 11/29/81  
Completed: 12/12/81

FORMATION	FROM	TO	REMARKS
Surface sand & red bed	0'	2898'	LTD: 5980'
Lime & Shale	2898'	5980'	RTD: 5980'

RECEIVED  
STATE CORPORATION COMMISSION  
DEC 21 1981  
CONSERVATION DIVISION  
Wichita, Kansas

I certify that this is a true and correct copy of the log on the above captioned well to the best of my knowledge.

NRG Drilling, Inc.

By Elmer Jack Taylor  
Elmer Jack Taylor, Vice-President

Subscribed and sworn to be fore me this 17 day of December 19 81

STATE NOTARY PUBLIC  
MARNELL PRIBBLE  
Seward County, Kansas  
My Appt. Expires 8-20-83

Marnell Pribble  
Notary Public  
Marnell Pribble

My commission expires: 8-20-83