

STATE OF KANSAS  
STATE CORPORATION COMMISSION

WELL PLUGGING RECORD

Give All Information Completely  
Make Required Affidavit  
Mail or Deliver Report to:  
Conservation Division  
State Corporation Commission  
211 No. Broadway  
Wichita, Kansas

Meade County, Sec. 35 Twp. 33S Rge. 29 (E) (W)

Location as "NE/CNW&SW&" or footage from lines 330' fr. North and 1650' fr. East

Lease Owner The Shamrock Oil and Gas Corporation

Lease Name Frank L. Feldman Well No. 1

Office Address Box 631, Amarillo, Texas

Character of Well (completed as Oil, Gas or Dry Hole) Dry Hole

Date well completed February 10, 19 59

Application for plugging filed February 10, 19 59

Application for plugging approved February 10, 19 59


Plugging commenced February 11, 19 59

Plugging completed February 11, 19 59

Reason for abandonment of well or producing formation Dry Hole

If a producing well is abandoned, date of last production 19

Was permission obtained from the Conservation Division or its agents before plugging was commenced? Yes

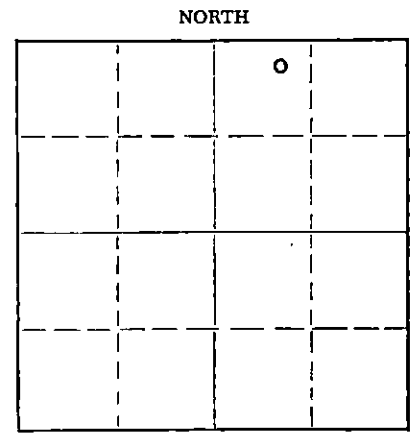

Locate well correctly on above Section Flat

Name of Conservation Agent who supervised plugging of this well Merle Rives (Rep. Indian Agency)

Producing formation None Depth to top Bottom Total Depth of Well 5775' Feet

Show depth and thickness of all water, oil and gas formations.

OIL, GAS OR WATER RECORDS

CASING RECORD

FORMATION	CONTENT	FROM	TO	SIZE	PUT IN	PULLED OUT
Sand	Water	425	575	9 5/8"	1551	-0-

Describe in detail the manner in which the well was plugged, indicating where the mud fluid was placed and the method or methods used in introducing it into the hole. If cement or other plugs were used, state the character of same and depth placed, from feet to feet for each plug set.

Pushed 9 5/8" OD Halliburton plug to 600' with 1 sack cottonseed hulls below plug. Potted 25 sacks cement on top of plug. Filled hole with heavy rotary mud. Pushed 9 5/8" OD Halliburton plug to 35' with 1 sacks hulls under plug. Filled hole to bottom of cellar with 15 sacks cement.

RECEIVED  
STATE CORPORATION COMMISSION  
FEB 14 1959  
2-14-59  
CONSERVATION DIVISION  
Wichita, Kansas

(If additional description is necessary, use BACK of this sheet)  
Name of Plugging Contractor Halliburton Oil Well Cementing Company  
Address Great Bend, Kansas

STATE OF TEXAS, COUNTY OF POTTER, ss.  
T. S. Clopton (employee of owner) or (owner) of the above-described well, being first duly sworn on oath, says: That I have knowledge of the facts, statements, and matters herein contained and the log of the above-described well as filed and that the same are true and correct. So help me God.

(Signature) T. S. Clopton  
Box 631, Amarillo, Texas (Address)

SUBSCRIBED AND SWORN TO before me this 13th day of February, 19 59

PAULINE POWELL  
Notary Public  
Potter County, Texas  
Notary Public.

My commission expires 6-1-59

PLUGGING  
FILE SEC. 35 T. 33 R. 29W  
BOOK PAGE 15 LINE 38

15-119-10148-0000

Co 7 Shamrock Oil & Gas  
Cont'd - D & M Oil Co

FRANK L. FELDMAN NO. 1  
Meade County, Kansas

35-33-290  
NE NW NE

*Dry*

0'	-	380'	Shale & clay
380'	-	425'	Shale
425'	-	575'	Sand
575'	-	1,260'	Shale, sand, & red bed
1,260'	-	1,570'	Shale & shells
1,570'	-	1,650'	Shale, anhydrite, & shells
1,650'	-	1,900'	Shale & shells
1,900'	-	2,190'	Shale & lime shells
2,190'	-	3,944'	Lime & shale
3,944'	-	4,145'	Shale with lime streaks
4,145'	-	4,251'	Shale & lime
4,251'	-	4,343'	Shale with lime streaks
4,343'	-	4,540'	Lime & shale
4,540'	-	4,605'	Lime
4,605'	-	4,770'	Lime & shale
4,770'	-	5,689'	Lime with shale streaks
5,689'	-	5,731'	Sand
5,731'	-	5,775'	Lime

RECEIVED  
STATE CORPORATION COMMISSION

FEB 14 1959

CONSERVATION DIVISION  
Wichita, Kansas

PLUGGING	
FILE	SEC. 35 T. 33 R. 29W
BOOK	PAGE 15 LINE 33