


WELL PLUGGING RECORD

Give All Information Completely
Make Required Affidavit
Mail or Deliver Report to:
Conservation Division
State Corporation Commission
211 No. Broadway
Wichita, Kansas

Clark County, Sec. 14 Twp. 34S Rge. (E) 22 (W)
Location as "NE/CNW'SW" or footage from lines 1320' S of N. Line, 50' W.
Lease Owner Graham-Michaelis Drilling, Inc. of E. Line
Lease Name Randall Well No. 2-14
Office Address 211 North Broadway, Wichita, Kansas 67202
Character of Well (completed as Oil, Gas or Dry Hole) Dry Hole
Date well completed July 27, 19 66
Application for plugging filed July 27, 19 66
Application for plugging approved Verbal July 27, 19 66
Plugging commenced July 27, 19 66
Plugging completed July 27, 19 66
Reason for abandonment of well or producing formation

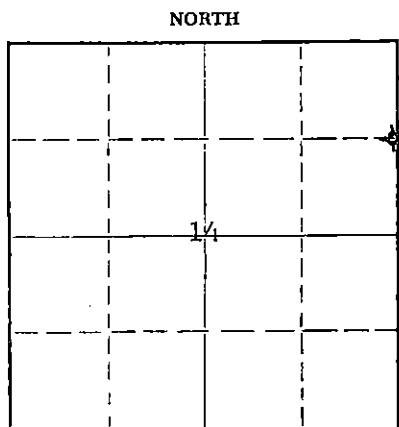

Locate well correctly on above
Section Plat

If a producing well is abandoned, date of last production 19
Was permission obtained from the Conservation Division or its agents before plugging was commenced? Yes

Name of Conservation Agent who supervised plugging of this well Edgar J. Eves, Sublette, Kansas
Producing formation none Depth to top Bottom Total Depth of Well 5485 Feet
Show depth and thickness of all water, oil and gas formations.

OIL, GAS OR WATER RECORDS

CASING RECORD

FORMATION	CONTENT	FROM	TO	SIZE	PUT IN	PULLED OUT
				8 5/8"	627'	none

Describe in detail the manner in which the well was plugged, indicating where the mud fluid was placed and the method or methods used in introducing it into the hole. If cement or other plugs were used, state the character of same and depth placed, from feet to feet for each plug set.

Filled hole with heavy drilling mud, cement plug with 35 sax cement at 675', filled with heavy drilling mud, cement plug with 15 sax cement at 45', cement below plow depth.

RECEIVED
STATE CORPORATION COMMISSION

AUG 1 1966

CONSERVATION DIVISION
Wichita, Kansas


(If additional description is necessary, use BACK of this sheet)

Name of Plugging Contractor Graham-Michaelis Drilling, Inc.
Address 211 North Broadway, Wichita, Kansas 67202

STATE OF Kansas, COUNTY OF Sedgwick, ss.
Jack L. Yinger (employee of owner) or (owner or operator) of the above-described well, being first duly sworn on oath, says: That I have knowledge of the facts, statements, and matters herein contained and the log of the above-described well as filed and that the same are true and correct. So help me God.

(Signature) Jack L. Yinger
Jack L. Yinger - Geologist
211 North Broadway, Wichita, Kansas 67202
(Address)

SUBSCRIBED AND SWORN TO before me this 28th day of July, 19 66

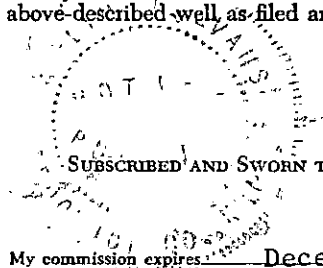

My commission expires December 12, 1966

Evelyn D. Evans
Notary Public.

RANDALL NO. 2-14

WELL RECORD:

LOCATION:

Section 14-34S-22W
Clark County, Kansas

Commenced: 7-11-66
Completed: 7-27-66
(Rotary)

CONTRACTOR:

Graham-Michaelis Drilling, Inc.
Liberal Division
P.O. Box 1294
Liberal, Kansas 67901

CASING RECORD:

22 Joints 8-5/8" 24# Casing
Cemented w/200 sx common and 2% cc
and w/200 sx Sunset

LOG

Surface Sand & Red Bed	0 - 378
Red Bed & Gyp	378 - 628
Red Bed & Shale	628 - 975
Red Bed, Sand, and Gyp	975 - 1533
Lime and Shale	1533 - 3642
Lime	3642 - 3698
Lime and Shale	3698 - 4778
Lime	4778 - 4866
Lime and Shale	4866 - 5008
Lime	5008 - 5150
Lime and Shale	5150 - 5485

5485' - Total Rotary Depth

The undersigned, Graham-Michaelis Drilling, Inc., Liberal Division, certifies that the above log is a true and correct copy of the formations encountered in drilling the above mentioned well, as taken from the Daily Drilling Report.

GRAHAM-MICHAELIS, INC.
LIBERAL DIVISION

By H. R. Michaelis

HRM:clm

RECEIVED
STATE CORPORATION COMMISSION
AUG 1 1966
CONSERVATION DIVISION
Wichita, Kansas