

15-025-30067-0000

STATE OF KANSAS  
STATE CORPORATION COMMISSION

Give All Information Completely  
Make Required Affidavit  
Mail or Deliver Report to:  
Conservation Division  
State Corporation Commission  
211 No. Broadway  
Wichita, Kansas

WELL PLUGGING RECORD

Clark County, Sec. 14 Twp. 34S Rge. (E) 22 (W)

Location as "NE/CNW%SW%" or footage from lines (20' E & 40' S of NW/4 SW/4)

Lease Owner Graham-Michaelis Drilling Company

Lease Name Randall Well No. 1-14

Office Address 211 North Broadway, Wichita, Kansas 67202

Character of Well (completed as Oil, Gas or Dry Hole) Dry Hole

Date well completed October 12, 19 65

Application for plugging filed October 12, 19 65

Application for plugging approved (verbal) October 12, 19 65


Plugging commenced October 12, 19 65

Plugging completed October 12, 19 65

Reason for abandonment of well or producing formation Dry Hole

If a producing well is abandoned, date of last production ----- 19---

Was permission obtained from the Conservation Division or its agents before plugging was commenced? Yes

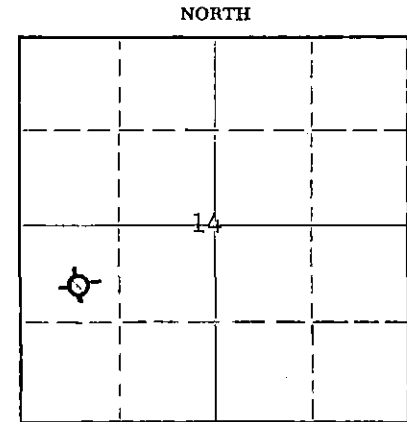

Locate well correctly on above Section Plat

Name of Conservation Agent who supervised plugging of this well Hugh E. Scott, Box F, Sublette, Kansas

Producing formation none Depth to top ----- Bottom ----- Total Depth of Well 5535' Feet

Show depth and thickness of all water, oil and gas formations.

OIL, GAS OR WATER RECORDS

CASING RECORD

FORMATION	CONTENT	FROM	TO	SIZE	PUT IN	PULLED OUT
				13 3/8"	116'	none
				8 5/8"	632'	none

Describe in detail the manner in which the well was plugged, indicating where the mud fluid was placed and the method or methods used in introducing it into the hole. If cement or other plugs were used, state the character of same and depth placed, from \_\_\_\_\_ feet to \_\_\_\_\_ feet for each plug set.

Filled hole with heavy drilling mud, put a cement plug with 35 sacks cement at 650', continued to fill hole with heavy drilling mud and put a cement plug with 15 sacks of cement at 45'.

RECEIVED  
STATE CORPORATION COMMISSION

OCT 28 1965

CONSERVATION DIVISION  
Wichita, Kansas

(If additional description is necessary, use BACK of this sheet)

Name of Plugging Contractor Graham-Michaelis Drilling Company

Address 211 North Broadway, Wichita, Kansas 67202

STATE OF Kansas, COUNTY OF Sedgwick, ss.

John L. James (employee of owner) of the above-described well, being first duly sworn on oath, says: That I have knowledge of the facts, statements, and matters herein contained and the log of the above-described well as filed and that the same are true and correct. So help me God.

(Signature) John L. James - Geol.


211 North Broadway, Wichita, Kansas 67202

(Address)

SUBSCRIBED AND SWORN TO before me this 27th day of October, 19 65

Everlynn D. Evans  
Notary Public.

My commission expires December 12, 1966

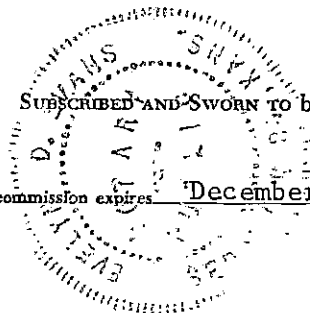

RANDALL #1-14

## WELL RECORD:

## LOCATION:

C NW SW Section 14-34S-22W  
Clark County, Kansas

Commenced: 9-26-65  
Completed: 10-12-65  
(Rotary)

## CONTRACTOR:

Graham-Michaelis Drilling, Inc.  
Liberal Division  
P. O. Box 1294  
Liberal, Kansas 67901

## CASING RECORD:

3 Joints (126') 13-3/8" 48# Casing  
Cemented w/100 sx Sunset

20 Joints 8-5/8" 24# Casing  
Cemented w/400 sx Lt. Wt. 2% cc

	<u>LOG</u>	
Red Bed	0 -	620
Red Bed & Sand	620 -	813
Red Bed	813 -	1520
Red Bed & Shale	1520 -	1969
Lime & Shale	1969 -	4660
Lime	4660 -	5450
Lime & Shale	5450 -	5500
Lime	5500 -	5535
		<u>5535' - Total Rotary Depth</u>

The undersigned, Graham-Michaelis Drilling, Inc., Liberal Division, certifies that the above log is a true and correct copy of the formations encountered in drilling the above mentioned well, as taken from the Daily Drilling Report.

GRAHAM-MICHAELIS DRILLING, INC.  
LIBERAL DIVISION

By H. R. Michaelis  
H. R. Michaelis

HRM/rw

**RECEIVED**  
STATE CORPORATION COMMISSION

OCT 28 1965

CONSERVATION DIVISION  
Wichita, Kansas