


STATE OF KANSAS
STATE CORPORATION COMMISSION

WELL PLUGGING RECORD

Give All Information Completely
Make Required Affidavit
Mail or Deliver Report to
Conservation Division
State Corporation Comm.
245 North Water
Wichita, KS 67202

Clark County, Sec. 14 Twp. 34S Rge. 22W E/W
Location as "NE/CNW $\frac{1}{4}$ SW $\frac{1}{4}$ " or footage from lines _____

C-NW
Lease Owner Beren Corporation
Lease Name Randall Well No. B-1
Office Address 970 Fourth Financial Center, Wichita, KS 67202
Character of Well (Completed as Oil, Gas or Dry Hole) _____
dry hole

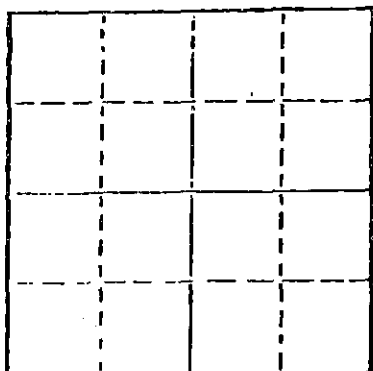

Locate well correctly on above
Section Plot

Date Well completed 4/10/81 19
Application for plugging filed 4/9/81 19
Application for plugging approved 4/9/81 19
Plugging commenced 4/9/81 19
Plugging completed 4/9/81 19
Reason for abandonment of well or producing formation _____
dry hole

If a producing well is abandoned, date of last production _____
19

Was permission obtained from the Conservation Division or
its agents before plugging was commenced? yes

Name of Conservation Agent who supervised plugging of this well Clarence Thomas
Producing formation _____ Depth to top _____ Bottom _____ Total Depth of Well _____
Show depth and thickness of all water, oil and gas formations.

OIL, GAS OR WATER RECORDS

CASING RECORD

FORMATION	CONTENT	FROM	TO	SIZE	PUT IN	PULLED OUT

Describe in detail the manner in which the well was plugged, indicating where the mud fluid
was placed and the method or methods used in introducing it into the hold. If cement or other
plugs were used, state the character of same and depth placed, from _____ feet to
_____ feet for each plug set.

Hole plugged with common as follows:
60 sacks @ 730', 10 sacks @ 40',
5 sacks in Rat Hole, 5 sacks mouse hole.
Plugging completed at 5:15 PM, April 9, 1981.

(If additional description is necessary, use BACK of this sheet)

Name of Plugging Contractor HOWCO

STATE OF Kansas COUNTY OF Sedgwick, ss.
Jerome D. Marcus (employee of owner) or (owner or operator)
of the above-described well, being first duly sworn on oath, says: That I have knowledge of
the facts, statements, and matters herein contained and the log of the above-described well
as filed and that the same are true and correct. So help me God.

(Signature) [Signature]
401 E. Douglas, Suite 402, Wichita, KS 67202
(Address)

SUBSCRIBED AND SWORN TO before me this 13th day of May, 1981.



My commission expires 4/27/85

[Signature]
Notary Public.

DRILLERS LOG

RANDALL B-1
Clark County
C NW
Sec. 14-34S-22W

Company: Beren Corporation

Contractor: BEREDCO INC.

Comm: 3/24/81

Comp.: 4/10/81

Casing: 8 5/8", 24# set at 701' with 375 sacks Hallolite 3% CC and
120 sacks common 3% CC
dry hole

<u>FORMATION</u>	<u>FROM</u>	<u>TO</u>
RB	0'	710'
RB & Shale	710'	1730'
Shale & Lime	1730'	5430'
Morrow	5430'	5430'
Lime & Shale	5430'	5660'

Rotary total depth - 5660'


STATE OF KANSAS

SS:

COUNTY OF SEDGWICK

I certify that this is a true and correct copy of the above log as shown by the drilling reports.

BEREDCO

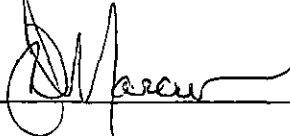

Subscribed and sworn to before me this 13th day of May, 1981.



