

STATE OF KANSAS  
STATE CORPORATION COMMISSION


WELL PLUGGING RECORD

Give All Information Completely  
Make Required Affidavit  
Mail or Deliver Report to:  
Conservation Division  
State Corporation Commission  
211 No. Broadway  
Wichita, Kansas

Clark County. Sec. 13 Twp. 34S Rge. (E) 22 (W)

Location as "NE/CNW/SW" or footage from lines 1640' NSL, 1320' WEL  
Lease Owner Ashland Oil & Refining Company  
Lease Name Harper Randall Well No. 1  
Office Address 720 NW 50th, Oklahoma City, Oklahoma  
Character of Well (completed as Oil, Gas or Dry Hole) Oil  
Date well completed November 4 19 62  
Application for plugging filed April 5 19 66  
Application for plugging approved April 6 19 66  
Plugging commenced April 13 19 66  
Plugging completed April 16 19 66  
Reason for abandonment of well or producing formation Depleted

NORTH

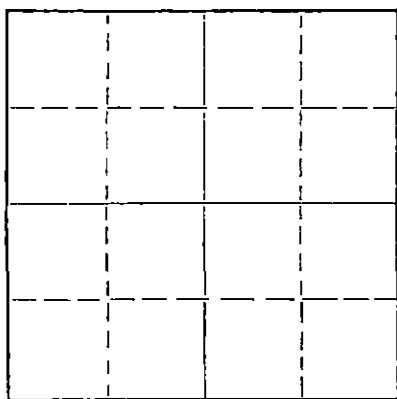

Locate well correctly on above  
Section Plat

If a producing well is abandoned, date of last production April 19 66  
Was permission obtained from the Conservation Division or its agents before plugging was commenced? Yes

Name of Conservation Agent who supervised plugging of this well Edgar Eves, Sublette, Kansas  
Producing formation Morrow Depth to top 5395 Bottom 5402 Total Depth of Well 5530 Feet  
Show depth and thickness of all water, oil and gas formations.

OIL, GAS OR WATER RECORDS

CASING RECORD

FORMATION	CONTENT	FROM	TO	SIZE	PUT IN	PULLED OUT
Morrow	Oil	5395	5402	8 5/8	567	0
				4 1/2	5530	4997

Describe in detail the manner in which the well was plugged, indicating where the mud fluid was placed and the method or methods used in introducing it into the hole. If cement or other plugs were used, state the character of same and depth placed, from \_\_\_\_\_ feet to \_\_\_\_\_ feet for each plug set.

Pumped 20 sacks cement with two 4 1/2" rubber plugs to 5100 feet. Filled hole with mud and worked 4 1/2" casing. Shot casing at 5002', kept hole full of mud and worked casing. Pulled 154 joints of 4 1/2" casing. Refilled hole with mud and capped 8 5/8" casing with 15 sacks cement. Had plate welded on top of surface casing.

RECEIVED  
STATE CORPORATION COMMISSION

MAY 5 - 1966

CONSERVATION DIVISION  
Wichita, Kansas

(If additional description is necessary, use BACK of this sheet)

Name of Plugging Contractor Gayle E. Toland & Co.  
Address 1317 SE 29th Street, Oklahoma City, Oklahoma

STATE OF Oklahoma, COUNTY OF Oklahoma, ss.  
Robert H. Tompkins (employee of owner) or (owner or operator) of the above-described well, being first duly sworn on oath, says: That I have knowledge of the facts, statements, and matters herein contained and the log of the above-described well as filed and that the same are true and correct. So help me God.

(Signature) Robert H. Tompkins  
P. O. Box 18695, Oklahoma City, Oklahoma  
(Address)

SUBSCRIBED AND SWORN TO before me this 3 day of May, 19 66

My commission expires 3-8-70

Jane Lohr Whitfield  
Notary Public.



15-025-10061-0000  
 1640' NSL, 1320' WEL  
 Section 13-34S-22W  
 Clark County, Kansas

HARPER-RANDALL WELL NO. 1

CONTRACTOR: The R. W. Rine Drilling Company

STARTED: September 18, 1962

COMPLETED: October 5, 1962

LOG

Red Bed	0'	-	577'
Red Bed, Gyp	577'	-	1310'
Shale, Anhydrite	1310'	-	1980'
Gyp, Anhydrite, Shale	1980'	-	2234'
Anhydrite, Lime	2234'	-	2377'
Lime, Shale	2377'	-	2569'
Lime, Shale Anhydrite	2569'	-	2704'
Lime, Shale	2704'	-	2880'
Cherty, Chalky Lime & Shale	2880'	-	2970'
Lime, Shale, Chalk Stringers	2970'	-	3120'
Shale, Lime	3120'	-	3755'
Shale	3755'	-	3885'
Shale, Lime	3885'	-	4277'
Shale	4277'	-	4480'
Shale, Lime	4480'	-	4545'
Lime	4545'	-	4707'
Sandy Lime	4707'	-	4777'
Lime	4777'	-	4876'
Lime, Sandy Lime	4876'	-	4958'
Lime	4958'	-	5093'
Cherty Lime, Sand	5093'	-	5139'
Lime	5139'	-	5390'
Lime, Sand	5390'	-	5399'
Lime	5399'	-	5531'

TTD 8-5/8" Csg. @577' w/500 Cu. ft. pozmix w/2% cc; cemented 100 sx. through 1" around csg. Completed w/ 72 sx. Redi-mix around top of csg.

Totco @1782' 1°

Totco @2472' 1/2°

Totco @3385' 1°

Totco @3777' 1/2°

Totco @4876' 3/4°

T. D. 4-1/2" Csg. @5531' w/100 Sx. Pozmix.

RECEIVED  
 STATE CORPORATION COMMISSION  
 CONSERVATION DIVISION  
 MAY 20 1966  
 Wichita, Kansas

COPY

STATE OF KANSAS )  
 COUNTY OF SEDGWICK ) ss

I, R. M. Green, do hereby certify that the above is a true and accurate log of the Harper-Randall Well No., located 1640' NSL, 1320' WEL, Section 13-34S-22W, Clark County, Kansas.

*R. M. Green*  
 Secretary-Treasurer

Subscribed and sworn to before me this 16th day of October, 1962.

*John E. Baker*  
 Notary Public

My Commission Expires: June 14, 1966