

STATE OF KANSAS
STATE CORPORATION COMMISSION

WELL PLUGGING RECORD

Give All Information Completely
Make Required Affidavit
Mail or Deliver Report to
Conservation Division
State Corporation Comm.
245 North Water
Wichita, KS 67202

Clark County. Sec. 12 Twp. 34S Rge. 22W E/W
Location as "NE/CNW $\frac{1}{4}$ SW $\frac{1}{4}$ " or footage from lines

C NW SE
Lease Owner Hummon Corporation
Lease Name Mell Well No. 1

Office Address 400 One Main Place, Wichita, Kansas 67202


Character of Well (Completed as Oil, Gas or Dry Hole)
Dry Hole

Date Well completed June 9, 1981
Application for plugging filed June 9, 1981
Application for plugging approved June 9, 1981
Plugging commenced June 9, 1981
Plugging completed June 9, 1981
Reason for abandonment of well or producing formation
Dry Hole

If a producing well is abandoned, date of last production
19

Was permission obtained from the Conservation Division or
its agents before plugging was commenced? Yes

Name of Conservation Agent who supervised plugging of this well Clarence Thomas, Jr.
Producing formation _____ Depth to top _____ Bottom _____ Total Depth of Well 5500'
Show depth and thickness of all water, oil and gas formations.

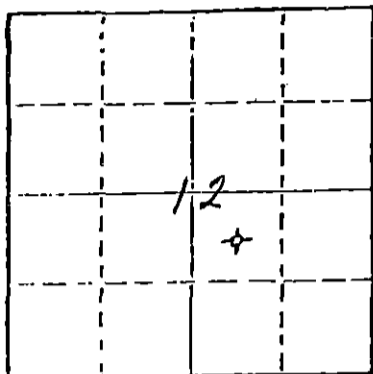

Locate well correctly on above
Section Plot

OIL, GAS OR WATER RECORDS

CASING RECORD

FORMATION	CONTENT	FROM	TO	SIZE	PUT IN	PULLED OUT
		0	606'	8-5/8"	599.40'	None

Describe in detail the manner in which the well was plugged, indicating where the mud fluid was placed and the method or methods used in introducing it into the hold. If cement or other plugs were used, state the character of same and depth placed, from _____ feet to _____ feet for each plug set.

Plugged with 60 sacks cement at 600';
10 sacks cement at 40'; and 5 sacks
cement in rat hole.

RECEIVED
STATE CORPORATION COMMISSION

7-2-81
JUL 2 1981

(If additional description is necessary, use BACK of this sheet)

Name of Plugging Contractor Allied Cementing Co.

CONSERVATION DIVISION
Wichita, Kansas

STATE OF KANSAS COUNTY OF SEDGWICK, ss.
John D. Knightley Agent (employee of owner) or (owner or operator)
of the above-described well, being first duly sworn on oath, says: That I have knowledge of
the facts, statements, and matters herein contained and the log of the above-described well
as filed and that the same are true and correct. So help me God.

(Signature) John D. Knightley
221 S. Broadway, Suite 400, Wichita, KS 67202
(Address)

30th day of June, 1981



Stella J. Lipp
Notary Public.

My commission expires March 12, 1983

Hummon Corporation
400 One Main Place
Wichita, Kansas 67202

-

Mell #1
C NW SE Sec. 12-34S-22W
Clark County, Kansas

Contractor: D. R. Lauck Oil Company, Inc.
221 S. Broadway, Suite 400
Wichita, Kansas 67202

Commenced: May 29, 1981
Completed: June 9, 1981

Drillers Log

Red Bed, Clay	1355
Clay & Shale	1956
Shale	3190
Shale & Lime	4475
Lime & Shale	4595
Shale & Lime	4728
Lime & Shale	4850
Lime	4945
Lime & Shale	5150
Lime	5338
Lime & Shale	5460
Lime	5500 RTD

RECEIVED
STATE CORPORATION COMMISSION

JUL - 2 1981

CONSERVATION DIVISION
Wichita, Kansas