


STATE OF KANSAS  
STATE CORPORATION COMMISSION

Form CP-4

Give All Information Completely  
Make Required Affidavit  
Mail or Deliver Report to:  
Conservation Division  
State Corporation Commission  
P. O. Box 17027  
Wichita, Kansas 67217

WELL PLUGGING RECORD

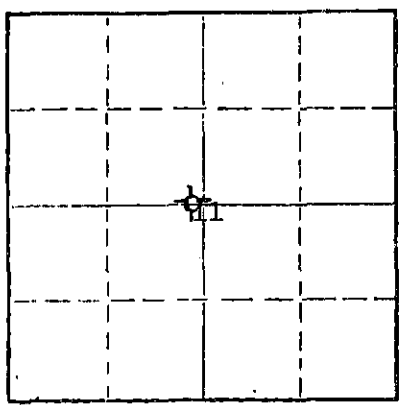

Locate well correctly on above Section Plat

Clark County, Sec. 11 Twp. 34S Rge. (E) 22 (W)  
Location as "NE/CNWxSWx" or footage from lines 50' West of Center  
Lease Owner Graham-Michaelis Corporation  
Lease Name Randall Well No. 1-11  
Office Address P. O. Box 247, Wichita, Kansas 67201  
Character of Well (completed as Oil, Gas or Dry Hole) Gas Well  
Date well completed March 3, 1965  
Application for plugging filed September 25, 1973  
Application for plugging approved September 26, 1973  
Plugging commenced October 17, 1973  
Plugging completed October 17, 1973  
Reason for abandonment of well or producing formation Non-commercial

If a producing well is abandoned, date of last production September 17, 1973  
Was permission obtained from the Conservation Division or its agents before plugging was commenced? Yes

Name of Conservation Agent who supervised plugging of this well Edgar Eves, P. O. Box "F", Sublette, Ks 67877  
Producing formation Morrow Sand Depth to top 5376 Bottom 5385 Total Depth of Well 5528 Feet  
Show depth and thickness of all water, oil and gas formations.

OIL, GAS OR WATER RECORDS

CASING RECORD

FORMATION	CONTENT	FROM	TO	SIZE	PUT IN	PULLED OUT
Morrow Sand	gas	5378	5394	8 5/8"	598'	none
				4 1/2"	5527'	4612'

Describe in detail the manner in which the well was plugged, indicating where the mud fluid was placed and the method or methods used in introducing it into the hole. If cement or other plugs were used, state the character of same and depth placed, from \_\_\_\_\_ feet to \_\_\_\_\_ feet for each plug set.

- 25 sacks cement plug at bottom of hole to 4800'
- 35 sacks cement plug at bottom of surface pipe (548'-648')
- 15 sacks cement at top from 3' to 45'

RECEIVED  
STATE CORPORATION COMMISSION  
OCT 30 1973  
CONSERVATION DIVISION  
Wichita, Kansas

(If additional description is necessary, use BACK of this sheet)  
Name of Plugging Contractor Lillard Casing Pulling  
Address 1906 Main, Woodward, Oklahoma

STATE OF Kansas COUNTY OF Sedgwick ss.  
Muriel F. C. Jeram (employee of owner) or (owner or operator) of the above-described well, being first duly sworn on oath, says: That I have knowledge of the facts, statements, and matters herein contained and the log of the above-described well as filed and that the same are true and correct. So help me God.

(Signature) Muriel F. C. Jeram  
P. O. Box 247, Wichita, Kansas 67201  
(Address)

SUBSCRIBED AND SWORN TO before me this 29th day of October, 1973.

My commission expires  
EVELYN D. EVANS  
NOTARY PUBLIC  
SEDGWICK COUNTY, KANSAS  
MY COMMISSION EXPIRES  
DECEMBER 12, 1974

Evelyn D. Evans  
Notary Public.

RANDALL #1-11

WELL RECORD:

LOCATION:

50' W. of C Section 11-34S-22W  
Clark County, Kansas

Commenced: 2-5-65  
Completed: 2-24-65  
(Rotary)

CONTRACTOR:

Graham-Michaelis Drilling, Inc.  
Liberal Division  
P. O. Box 1294  
Liberal, Kansas

CASING RECORD:

18 Joints 24# 8-5/8" Casing  
Cemented w/300 sx Common 2% cc  
.6% Gel

RECEIVED  
STATE CORPORATION COMMISSION  
SEP 26 1973  
CONSERVATION DIVISION  
Wichita, Kansas

	<u>LOG</u>	
Sand & Red Bed	0 -	543
Red Bed	543 -	1158
Red Bed & Shale	1158 -	1610
Lime & Shale	1610 -	4828
Lime	4828 -	4880
Lime & Shale	4880 -	5026
Lime	5026 -	5129
Lime & Shale	5129 -	5247
Lime	5247 -	5339
Lime & Shale	5339 -	5528

5528' - Total Rotary Depth

The undersigned, Graham-Michaelis Drilling, Inc., Liberal Division, certifies that the above log is a true and correct copy of the formations encountered in drilling the above mentioned well, as taken from the Daily Drilling Report.

GRAHAM-MICHAELIS DRILLING, INC.  
LIBERAL DIVISION

By: *H. R. Michaelis*  
H. R. Michaelis