

15 025-10/31-0000

STATE OF KANSAS  
STATE CORPORATION COMMISSION


Give All Information Completely  
Make Required Affidavit  
Mail & Deliver Report to:  
Conservation Division  
State Corporation Commission  
211 No. Broadway  
Wichita, Kansas

# WELL PLUGGING RECORD

Clark County, Sec. 33 Twp. 34 Rge. (E) 21(W)

Location as "NE/CNW/SW" or footage from lines Ctr SW NW  
Lease Owner TEXACO INC.  
Lease Name E. Campbell "B" Well No. 1  
Office Address 614 Bitting Bldg., Wichita, Kansas  
Character of Well (completed as Oil, Gas or Dry Hole) Gas and Oil  
Date well completed 3-14-1961  
Application for plugging filed 7-1-1962  
Application for plugging approved 9-7-1962  
Plugging commenced 9-19-1962  
Plugging completed 9-27-1962  
Reason for abandonment of well or producing formation Non-Commercial  
If a producing well is abandoned, date of last production 8-1-1962  
Was permission obtained from the Conservation Division or its agents before plugging was commenced? Yes

NORTH

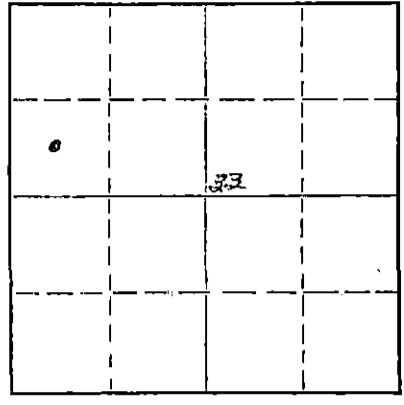

Locate well correctly on above Section Plat

Name of Conservation Agent who supervised plugging of this well Hugh E. Scott  
Producing formation Morrow Depth to top 5518 Bottom 5598 Total Depth of Well 5695 Feet  
Show depth and thickness of all water, oil and gas formations.

### OIL, GAS OR WATER RECORDS

### CASING RECORD

FORMATION	CONTENT	FROM	TO	SIZE	PUT IN	PULLED OUT
Marmaton	Water	5181	5343	13-3/8	156'	0
Cherokee	Water	5343	5480	8-5/8"	607'	0
Morrow Sec.	Dry	5480	5518	4-1/2"	5694'	4906'
Morrow	Water, Oil, Gas	5518	5598			
Mississippi	Dry	5598	5695			

Describe in detail the manner in which the well was plugged, indicating where the mud fluid was placed and the method or methods used in introducing it into the hole. If cement or other plugs were used, state the character of same and depth placed, from \_\_\_\_\_ feet to \_\_\_\_\_ feet for each plug set.

- PBTD 5527'
- 5527 - 5510' with 2 sacks cement
- 5510 - 607' with Heavy mud
- 607 - 597' Rock bridge
- 597 - 507' with 35 sacks cement
- 507 - 45' with Heavy mud
- 45 - 38' Rock bridge
- 38 - 6' 15 sacks Portland
- 6 - 0' Surface clay

**RECEIVED**  
STATE CORPORATION COMMISSION

OCT 5 1962  
10-5-62  
CONSERVATION DIVISION  
Wichita, Kansas

(If additional description is necessary, use BACK of this sheet)

Name of Plugging Contractor Ralph Comstock  
Address Stafford, Kansas

STATE OF Kansas, COUNTY OF Sedgwick, ss.  
M. C. Harrell (employee of owner) of the above-described

well, being first duly sworn on oath, says: That I have knowledge of the facts, statements, and matters herein contained and the log of the above-described well as filed and that the same are true and correct. So help me God.

(Signature) M. C. Harrell  
614 Bitting Bldg., Wichita, Kansas  
(Address)

SUBSCRIBED AND SWORN TO before me this 2nd day of October, 1962

My commission expires 6-20-64

A. E. Boyd  
Notary Public.



## ROTARY DRILLED LOG

OPERATOR: Texaco, Inc.  
Campbell "B" #1  
C SW NE of Sec. 33-34-21W,  
Clark County, Kansas

CONTRACTOR: Capitt Drilling, Inc.  
DATE: 1-21-61  
COMP: 2-11-61

Remarks: Set 160' of 13-5/8" casing  
cemented with 300 ex. Pos.  
w/Ht-5.

Set 8-5/8" casing at 607'  
cemented with 375 ex. Pos.,  
w/6X Gal, 1/4# Flocale 6  
2X C.C.

## Formations:

Sand	80'
Red Bed	920'
Shale & Lime streaks	1490'
Shale & Lime	1798'
Lime & Shale	2070'
Shale & Lime	2276'
Lime	3260'
Shale	3392'
Shale & Lime	3528'
Lime	3647'
Shale & Lime	3742'
Lime	4050'
Shale & Lime	4192'
Lime	4312'
Lime & Shale	4476'
Lime	5122'
Lime & Shale	5172'
Lime	5502'
Lime & Sand	5596'
Lime	5695'
Rotary Total Depth	5695'

Set 4-1/2" casing at 5694' cemented with  
150 ex. Pozmix.

We certify the above log is true and correct  
to the best of our knowledge and belief.

CAPITT DRILLING, INC.

*R.R. McNiccol*

R. R. McNiccol