

STATE OF KANSAS
STATE CORPORATION COMMISSION

WELL PLUGGING RECORD

Give All Information Completely
Make Required Affidavit
Mail or Deliver Report to
Conservation Division
State Corporation Comm.
245 North Water
Wichita, KS 67202

Clark County. Sec. 28 Twp. 34S Rge. 21 E/W
Location as "NE/CNW/SW" or footage from lines
N/2 NW NE


Lease Owner Pickrell Drilling Company
Lease Name #2 Barby Harper Well No.
Office Address 110 N. Market, Suite 205, Wichita, KS 67202
Character of Well (Completed as Oil, Gas or Dry Hole)
Dry Hole

Date Well completed 6-27 1981
Application for plugging filed 6-27 1981
Application for plugging approved 6-27 1981
Plugging commenced 6-27 1981
Plugging completed 6-27 1981
Reason for abandonment of well or producing formation
Dry Hole

If a producing well is abandoned, date of last production
19

Was permission obtained from the Conservation Division or
its agents before plugging was commenced? Yes

Name of Conservation Agent who supervised plugging of this well Clarence Thomas, Jr.
Producing formation Depth to top Bottom Total Depth of Well 5586'
Show depth and thickness of all water, oil and gas formations.

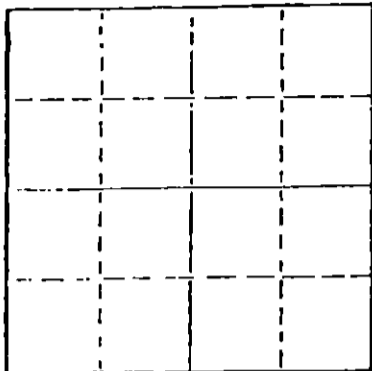

Locate well correctly on above
Section Plat

OIL, GAS OR WATER RECORDS

CASING RECORD

FORMATION	CONTENT	FROM	TO	SIZE	PUT IN	PULLED OUT
				8 5/8"	602' KB	None

Describe in detail the manner in which the well was plugged, indicating where the mud fluid was placed and the method or methods used in introducing it into the hold. If cement or other plugs were used, state the character of same and depth placed, from feet to feet for each plug set.

60 sx at 570'
10 sx at 40' w/solid bridge plug
5 sx rathole, comp 4:45 p.m. on 6-27-81

RECEIVED
STATE CORPORATION COMMISSION

7-7-81
7 1981

(If additional description is necessary, use BACK of this sheet)

Name of Plugging Contractor Pickrell Drilling Company
CONSERVATION DIVISION
Wichita, Kansas

STATE OF Kansas COUNTY OF Sedgwick, ss.
C. W. Sebitts (Employee of owner) or (owner or operator)

of the above-described well, being first duly sworn on oath, says: That I have knowledge of the facts, statements, and matters herein contained and the log of the above-described well as filed and that the same are true and correct. So help me God.

(Signature)

110 N. Market, Suite 205, Wichita, KS 67202
(Address)

SUBSCRIBED AND SWORN TO before me this 6th day of July, 1981

My commission expires December 9, 1982

Jana Lea Schneeweis
JANA LEA SCHNEWEIS
STATE NOTARY PUBLIC
Sedgwick County, Kansas
Notary Public.

KANSAS

WELL COMPLETION REPORT AND DRILLER'S LOG

S. 28 T. 34S R. 21
Loc. N/2 NW NE
County Clark

API No. 15 — 025 — 20,478
County Number

Operator
Pickrell Drilling Company

Address
205 Litwin Building, 110 North Market


Well No. 2 Lease Name Barby-Harper

Footage Location
feet from (N) (S) line feet from (E) (W) line

Principal Contractor Geologist
Pickrell Drilling Company Claud Sheats

Spud Date Date Completed Total Depth P.B.T.D.
6-11-81 6-27-81 5586'

Directional Deviation Oil and/or Gas Purchaser

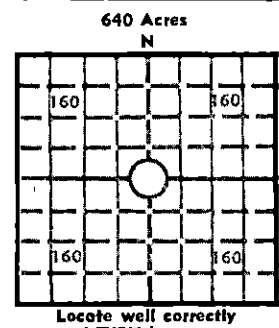

Elev.: Gr. 1777'
DF. KB 1782'

CASING RECORD

Report of all strings set — surface, intermediate, production, etc.

Purpose of string	Size hole drilled	Size casing set (in O.D.)	Weight lbs./ft.	Setting depth	Type cement	Sacks	Type and percent additives
		8 5/8"		602' KB		300 sx	

LINER RECORD

PERFORATION RECORD

Top, ft.	Bottom, ft.	Sacks cement	Shots per ft.	Size & type	Depth interval

Size	Setting depth	Packer set at

ACID, FRACTURE, SHOT, CEMENT SQUEEZE RECORD

Amount and kind of material used	Depth interval treated

RECEIVED
STATE CORPORATION COMMISSION

INITIAL PRODUCTION

JUL - 7 1981

Date of first production	Producing method (flowing, pumping, gas lift, etc.)

RATE OF PRODUCTION PER 24 HOURS	Oil	Gas	Water	Gas-oil ratio
	bbls.	MCF	bbls.	CFPB
Disposition of gas (vented, used on lease or sold)			Producing interval (s)	

CONSERVATION DIVISION
Wichita, Kansas

INSTRUCTIONS: As provided in KCC Rule 82-2-125, within 90 days after completion of a well, one completed copy of this Drillers Log shall be transmitted to the State Geological Survey of Kansas, 4150 Monroe Street, Wichita, Kansas 67209. Copies of this form are available from the Conservation Division, State Corporation Commission, 245 No. Water, Wichita, Kansas 67202. Phone AC 316-522-2206. If confidential custody is desired, please note Rule 82-2-125. Drillers Logs will be on open file in the Oil and Gas Division, State Geological Survey of Kansas, Lawrence, Kansas 66044.

Operator Pickrell Drilling Company DESIGNATE TYPE OF COMP.: OIL, GAS, DRY HOLE, SWDW, ETC.: Dry Hole

Well No. 2 Lease Name Barby-Harper

S 28 T 34S R 21 W

WELL LOG

Show all important zones of porosity and contents thereof; corad intervals, and all drill-stom tests, including depth interval tested, cushion used, time tool open, flowing and shut-in pressures, and recoveries.

SHOW GEOLOGICAL MARKERS, LOGS RUN, OR OTHER DESCRIPTIVE INFORMATION.

FORMATION DESCRIPTION, CONTENTS, ETC.	TOP	BOTTOM	NAME	DEPTH
Surface Sand Redbed	95			
Shale	1390			
Lime & Shale	2655			
Shale	2780			
Shale & Lime	2905			
Lime & Shale	3385			
Shale & Lime	3645			
Lime & Shale	5520			
Lime	5586			

USE ADDITIONAL SHEETS, IF NECESSARY, TO COMPLETE WELL RECORD.

Date Received

C. W. Sebitts
Signature

C. W. Sebitts - Partner
Title

July 6, 1981
Date

ROTARY DRILLING LOG

COMPANY: Pickrell Drilling Company
205 Litwin Building, 110 North Market
Wichita, Kansas 67202
LOCATION: #2 Barby-Harper
N/2 NW NE, Sec. 28-34S-21W
Clark County, Kansas
CONTRACTOR: **PICKRELL DRILLING COMPANY**
Wichita, Kansas

Rotary Drilling Commenced 6-11-81
Rotary Drilling Completed 6-27-81

CASING RECORD: Spud 6-11-81, surface pipe 8 5/8", depth 602' KB, cem 300 sx.

LOG

(Figures indicate bottom of formation — measurements from top of rotary bushing.)

Surface Sand Redbed	95
Shale	1390
Lime & Shale	2655
Shale	2780
Shale & Lime	2905
Lime & Shale	3385
Shale & Lime	3645
Lime & Shale	5520
Lime	5586

RECEIVED
STATE CORPORATION COMMISSION
JUL - 7 1981
CONSERVATION DIVISION
Wichita, Kansas

The undersigned, C. W. Sebitts, Attorney-in-Fact for PICKRELL DRILLING COMPANY, hereby certifies in behalf of said Company, that the above is a true and correct log of the formation encountered in drilling the above well as reflected by the Daily Drilling Reports.

PICKRELL DRILLING COMPANY

By C. W. Sebitts Attorney-in-Fact

STATE OF KANSAS }
COUNTY OF SEDGWICK } ss.:

On this 6th day of July, 1981, before me the undersigned, a Notary Public, in and for the County and State aforesaid, personally appeared C. W. Sebitts, to me known to be the identical person who subscribed the name of PICKRELL DRILLING COMPANY to the foregoing instrument as its Attorney-in-Fact and acknowledged to me that he executed the same as his free and voluntary act and deed, and as the free and voluntary act and deed of such company, for the uses and purposes therein set forth.

Given under my hand and seal of office the day and year last above written.

My commission expires: December 9, 1982.

Jana Lea
Jana Lea
Notary Public
Sedgwick County, Kansas