


STATE OF KANSAS
STATE CORPORATION COMMISSION

WELL PLUGGING RECORD

Give All Information Completely
Make Required Affidavit
Mail or Deliver Report to:
Conservation Division
State Corporation Commission
212 North Market, Insurance Bldg.
Wichita, Kansas

Clark County, Sec. 25 Twp. 34S Rge. 21 W (E) (W)

Location as "NE/CNW&SW&" or footage from lines C NW SE
Lease Owner Jake L. Hamon
Lease Name Campbell Well No. 1
Office Address 511 Midland Savings Bldg., Midland, Texas
Character of Well (completed as Oil, Gas or Dry Hole) Dry Hole
Date well completed 17 November 19 62
Application for plugging filed 20 November 19 62
Application for plugging approved Verbal approval 17 November 19 62
Plugging commenced 17 November 19 62
Plugging completed 17 November 19 62
Reason for abandonment of well or producing formation Dry Hole

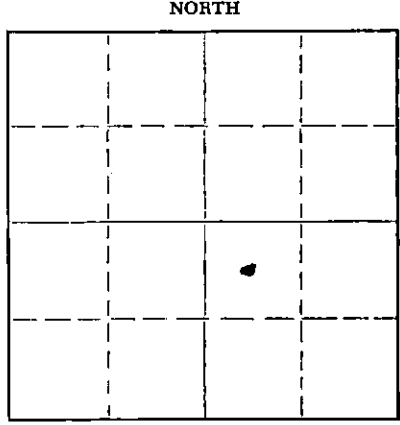

Locate well correctly on above Section Plat

If a producing well is abandoned, date of last production _____ 19____
Was permission obtained from the Conservation Division or its agents before plugging was commenced? Yes

Name of Conservation Agent who supervised plugging of this well Don Hall Liberal, Kansas
Producing formation None Depth to top _____ Bottom _____ Total Depth of Well 5600 Feet
Show depth and thickness of all water, oil and gas formations.

OIL, GAS OR WATER RECORDS

CASING RECORD

FORMATION	CONTENT	FROM	TO	SIZE	PUT IN	PULLED OUT
		K.B.	605.01'	9 5/8"	592'	None

Describe in detail the manner in which the well was plugged, indicating where the mud fluid was placed and the method or methods used in introducing it into the hole. If cement or other plugs were used, state the character of same and depth placed, from _____ feet to _____ feet for each plug set.
Pumped hole full of mud. Set 50 sack cement plug in and below bottom of 9 5/8" casing from 658' to 528' and set 15 sack plug in top of 9 5/8" casing.

STATE CORPORATION COMMISSION

11-26-62 NOV 20 1962

CONSERVATION DIVISION
WICHITA, KANSAS

(If additional description is necessary, use BACK of this sheet)
Name of Plugging Contractor Wakfield Drilling Company (Plugging Contract #199)
Address 515 Union Center Building, Wichita, Kansas

STATE OF Texas COUNTY OF Midland, ss.
R.T. Mayberry (employee of owner) or (owner or operator) of the above-described well, being first duly sworn on oath, says: That I have knowledge of the facts, statements, and matters herein contained and the log of the above-described well as filed and that the same are true and correct. So help me God.

(Signature) R T Mayberry
511 Midland Savings Bldg., Midland, Texas
(Address)

SUBSCRIBED AND SWORN TO before me this 21 day of November, 19 62

My commission expires June 1, 1963
Oleta Davis Notary Public.


15-025-00072-0000

STATE OF KANSAS
STATE CORPORATION COMMISSION

WELL PLUGGING RECORD

Give All Information Completely
Make Required Affidavit
Mail or Deliver Report to:
Conservation Division
State Corporation Commission
212 North Market, Insurance Bldg.
Wichita, Kansas

Clark County. Sec. 25 Twp. 34S Rge. 21 W (E) (W)
Location as "NE/CNW%SW%" or footage from lines C NW SE

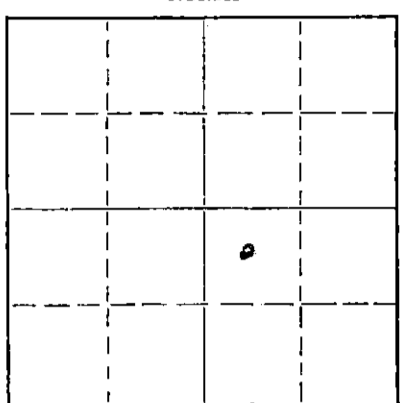

Lease Owner Jake L. Hamon
Lease Name Campbell Well No. 1
Office Address 511 Midland Savings Bldg., Midland, Texas
Character of Well (completed as Oil, Gas or Dry Hole) Dry Hole
Date well completed 17 November 1962
Application for plugging filed 20 November 1962
Application for plugging approved Verbal approval 17 November 1962
Plugging commenced 17 November 1962
Plugging completed 17 November 1962
Reason for abandonment of well or producing formation Dry Hole

Locate well correctly on above
Section Plat

If a producing well is abandoned, date of last production 19
Was permission obtained from the Conservation Division or its agents before plugging was commenced? Yes

Name of Conservation Agent who supervised plugging of this well Don Hall Liberal, Kansas
Producing formation None Depth to top Bottom Total Depth of Well 5600 Feet
Show depth and thickness of all water, oil and gas formations.

OIL, GAS OR WATER RECORDS

CASING RECORD

FORMATION	CONTENT	FROM	TO	SIZE	PUT IN	PULLED OUT
		K.B.	605.01'	9 5/8"	592'	None

Describe in detail the manner in which the well was plugged, indicating where the mud fluid was placed and the method or methods used in introducing it into the hole. If cement or other plugs were used, state the character of same and depth placed, from _____ feet to _____ feet for each plug set.
Pumped hole full of mud. Set 50 sack cement plug in and below bottom of 9 5/8" casing from 658' to 528' and set 15 sack plug in top of 9 5/8" casing.

RECEIVED
STATE CORPORATION COMMISSION
NOV 28 1962
CONSERVATION DIVISION
Wichita, Kansas

(If additional description is necessary, use BACK of this sheet)

Name of Plugging Contractor Wakfield Drilling Company (Plugging Contract #199)
Address 515 Union Center Building, Wichita, Kansas

STATE OF Texas, COUNTY OF Midland, ss.
R.T. Mayberry (employee of owner) or (owner or operator) of the above-described well, being first duly sworn on oath, says: That I have knowledge of the facts, statements, and matters herein contained and the log of the above-described well as filed and that the same are true and correct. So help me God.

(Signature) R T Mayberry
511 Midland Savings Bldg., Midland, Texas
(Address)

SUBSCRIBED AND SWORN TO before me this 21 day of November, 1962

My commission expires June 1, 1963

Oleta Davis
Notary Public.



LEASE: ELLA S. CAMPBELL #1
 OPERATOR: JAKE L. HAMON
 CONTRACTOR: EARL F. WAKEFIELD
 COMM: 10-23-62 COMP: 11-17-62

LOCATION: NW/4 SE/4
 SECTION 25-34S-21W
 CLARK COUNTY, KANSAS
 CASING: 16" Set at 100'
 9 5/8" Set at 604'

Sand	112
Gravel	145
Red Bed	685
Shale and Shells	1140
Red Shale	1308
Gray Lime Shale	1710
Shale Lime	1926
Lime and Shale	2375
Lime	2475
Lime and Shale	2598
Lime	2895
Lime and Shale	3050
Shale Lime	3190
Lime and Shale	3570
Lime	3660
Lime and Shale	4050
Shale Lime	4201
Lime and Shale	4260
Lime	4370
Lime and Shale	4494
Lime	4754
Lime and Shale	4837
Lime	4900
Lime with Shale	4985
Lime	5258
Lime with Shale	5322
Lime	5428
Sand	5436
Lime and Shale	5438
Lime and Sand	5500
Sandy Lime	5508
Lime	5600
T.D.	5600

RECEIVED
 STATE CORPORATION COMMISSION

NOV 26 1962

CONSERVATION DIVISION
 Wichita, Kansas

STATE OF KANSAS)
) ss
 COUNTY OF SEDGWICK)

I hereby certify that the above is a true and correct copy of the log on the Ella S. Campbell #1 well, located NW/4 SE/4 of Section 25-34S-21W, Clark County, Kansas.

EARL F. WAKEFIELD

By Fred S. Barber

Subscribed and sworn before me this 20th day of November, 1962.

My commission expires:
January 25, 1965

Thanda M. Riley
 NOTARY