


STATE OF KANSAS  
STATE CORPORATION COMMISSION

WELL PLUGGING RECORD

Give All Information Completely  
Make Required Affidavit  
Mail or Deliver Report to  
Conservation Division  
State Corporation Comm.  
245 North Water  
Wichita, KS 67202

Clark County. Sec. 24 Twp. 34S Rge. 21 ~~XX~~W  
Location as "NE/CNW $\frac{1}{4}$ SW $\frac{1}{4}$ " or footage from lines  
1400'FWL & 1785' FNL  
Lease Owner ( Zenith Drlg. Corp., Inc) Wainoco Oil & Gas  
Lease Name P. O'Brien Well No. 1  
Office Address Suite 600, 200 W. Douglas, Wichita, Ks.  
Character of Well (Completed as Oil, Gas or Dry Hole) dry hole

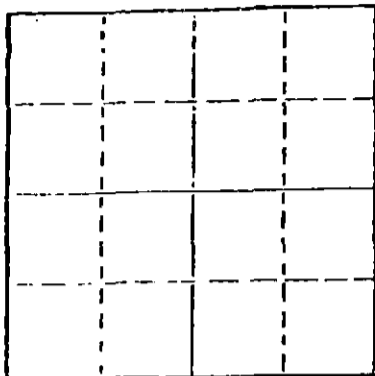

Locate well correctly on above  
Section Plat

Date Well completed 3-17-78  
Application for plugging filed 3-17-78  
Application for plugging approved 3-17-78  
Plugging commenced 3-17-78  
Plugging completed 3-17-78  
Reason for abandonment of well or producing formation

no commercial quantities of oil or gas encountered  
If a producing well is abandoned, date of last production 19

Was permission obtained from the Conservation Division or its agents before plugging was commenced?

Name of Conservation Agent who supervised plugging of this well  
Producing formation \_\_\_\_\_ Depth to top \_\_\_\_\_ Bottom \_\_\_\_\_ Total Depth of Well 5595  
Show depth and thickness of all water, oil and gas formations.

OIL, GAS OR WATER RECORDS

CASING RECORD

FORMATION	CONTENT	FROM	TO	SIZE	PUT IN	PULLED OUT
surface hole	shale	surf	602'	8-5/8	602'	none

Describe in detail the manner in which the well was plugged, indicating where the mud fluid was placed and the method or methods used in introducing it into the hold. If cement or other plugs were used, state the character of same and depth placed, from \_\_\_\_\_ feet to \_\_\_\_\_ feet for each plug set.

Fluid to 720', plug 60 sx  
Fluid to 40', plug 10 sx  
5 sx in rat hole

RECEIVED  
STATE CORPORATION COMMISSION  
MAR 28 1978

CONSERVATION DIVISION  
Wichita, Kansas

(If additional description is necessary, use BACK of this sheet)

Name of Plugging Contractor **D N B DRILLING, INC**  
515 R. H. Garvey Building

STATE OF Kansas COUNTY OF Sedgwick, ss.  
Ella Priess (employee of owner) or (owner or operator)

of the above-described well, being first duly sworn on oath, says: That I have knowledge of the facts, statements, and matters herein contained and the log of the above-described well as filed and that the same are true and correct. So help me God.

(Signature) Ella Priess  
Suite 515, R.H. Garvey Bldg., Wichita, Ks.  
(Address) 67202

SUBSCRIBED AND SWORN TO before me this 27th day of March, 19 78

My commission expires 4/30/79

Dorothy L. Schmidt  
Dorothy L. Schmidt Notary Public.

DOROTHY L. SCHMIDT  
STATE NOTARY PUBLIC  
Sedgwick County, Kansas  
My Appt. Exp. April 30, 1979

DRILLERS' LOG

ZENITH DRILLING CORPORATION, INC) Wainoco Oil & Gas Co. & Century Explor. Co.  
No. 1 P. O'Brien, et al  
1400' FWL & 1785' FNL  
Sec. 24-34S-21W  
Clark Co., Kansas

Commenced: 3-8-78  
Completed: 3-17-78  
Surface Casing: 603' of 8-5/8" cemented w/250 sx Halco Lite, 150 sx Halco Heavy, 3% cc. 3-8-78

<u>FORMATION</u>	<u>DEPTH</u>
Surface Hole	0 - 602
Red Bed & Shale	602 - 1693
Shale	1693 - 2080
Shale & Lime	2080 - 3510
Lime & Shale	3510 - 4286
Shale & Lime	4286 - 4350
Lime & Shale	4350 - 5425
Lime	5425 - 5595 RTD

RECEIVED  
STATE CORPORATION COMMISSION  
MAR 28 1978  
CONSERVATION DIVISION  
Wichita, Kansas

I do hereby certify that the foregoing statements are true and correct to the best of my knowledge and belief.

D N B DRILLING, INC.

*Ella Priess*

Ella Priess

STATE OF KANSAS: ss:

Subscribed and sworn to before me this 27th day of March, 1978.

*Dorothy L. Schmidt*  
Dorothy L. Schmidt, Notary Public

DOROTHY L. SCHMIDT  
STATE NOTARY PUBLIC  
Sedgwick County, Kansas  
My Appt. Exp. April 30, 1979