


STATE OF KANSAS
STATE CORPORATION COMMISSION
Give All Information Completely
Make Required Affidavit
Mail or Deliver Report to:
Conservation Division
State Corporation Commission
800 Bittling Building
Wichita, Kansas

WELL PLUGGING RECORD

Clark County, Sec. 24 Twp. 34S Rge. 21W (E) (W)

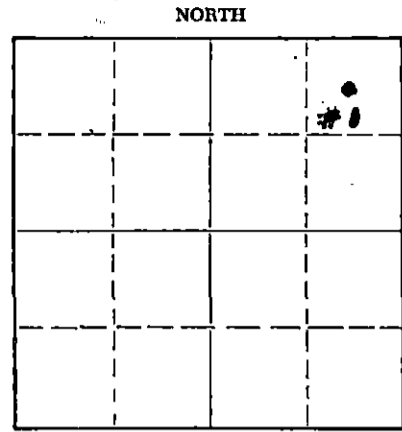

Locate well correctly on above Section Plat

Location as "NE/CNW&SW" or footage from lines C NE NE
Lease Owner Sinclair Oil & Gas Company
Lease Name Schumacher Well No. 1
Office Address P. O. Box 521, Tulsa, Oklahoma
Character of Well (completed as Oil, Gas or Dry Hole) Dry Hole
Date well completed 2-8 19 57
Application for plugging filed 2-7 19 57
Application for plugging approved 2-11 19 57
Plugging commenced 2-7 19 57
Plugging completed 2-8 19 57
Reason for abandonment of well or producing formation Dry hole. No producing formation encountered during drilling.

If a producing well is abandoned, date of last production Dry Hole. 19
Was permission obtained from the Conservation Division or its agents before plugging was commenced? Yes - verbal approval granted.

Name of Conservation Agent who supervised plugging of this well Mr. M. A. Rives, Box 8, Pratt, Kansas
Producing formation None Depth to top _____ Bottom _____ Total Depth of Well 560 1/4 Feet
Show depth and thickness of all water, oil and gas formations.

OIL, GAS OR WATER RECORDS CASING RECORD

FORMATION	CONTENT	FROM	TO	SIZE	PUT IN	PULLED OUT
<u>None - Dry Hole</u>				<u>20"</u>	<u>104'</u>	<u>None</u>
				<u>13-3/4"</u>	<u>670'</u>	<u>None</u>
				<u>8-5/8"</u>	<u>1653</u>	<u>791'</u>

Describe in detail the manner in which the well was plugged, indicating where the mud fluid was placed and the method or methods used in introducing it into the hole. If cement or other plugs were used, state the character of same and depth placed, from _____ feet to _____ feet for each plug set.

Ran McCullough Magnetector and found 8-5/8" OD casing free at 791'.
Cut 8-5/8" OD casing off at 791' with McCullough jet cutter.
Pulled 791' of 8-5/8" OD casing.
Mudded hole from 560 1/4' to 600'.
Dumped 1/4 sack of hulls at 600'.
Set Halliburton cement plug in 13-3/8" OD casing at 600'.
Dumped 35 sacks of cement from 600' to 548'.
Mudded hole from 548' to 35'.
Set Halliburton cement plug in 13-3/8" OD casing at 35'.
Dumped 10 sacks cement from 35' to surface.
Completed plugging and abandoning dry hole at 2-8-57 at 7 A.M.

(If additional description is necessary, use BACK of this sheet)
Name of Plugging Contractor Barbour Drilling Company
Address 1612 First Natl. Bldg., Tulsa, Oklahoma

STATE OF Kansas, COUNTY OF Rice, ss.
W. B. Rhees (employee of owner) or (owner or operator) of the above-described well, being first duly sworn on oath, says: That I have knowledge of the facts, statements, and matters herein contained and the log of the above-described well as filed and that the same are true and correct. So help me God.

(Signature) [Signature]
P. O. Box 551, Chase, Kansas
(Address)

SUBSCRIBED AND SWORN to before me this 12th day of February, 19 57

My commission expires 19 June 1959

[Signature]
Notary Public.

PLUGGING
FILE SEC 24 T 34 R 21W
BOOK PAGE 139 L E 36

RECEIVED
STATE CORPORATION COMMISSION

FEB 13 1957
CONSERVATION DIVISION
Wichita, Kansas

15-025-10118-0000

SCHUMACHER NO. 1
 NE/4 of Section 24-34S-21W
 Clark County, Kansas
 Sinclair Oil and Gas Company

13-3/8" O. D. casing cemented at 670'
 8-5/8" O. D. casing cemented at 1653'

Drilling commenced January 10, 1957
 Drilling completed February 8, 1957

FROM	TO	FORMATION	REMARKS
0'	40'	Sand	
40	90	Sand & clay	
90	675	Red rock	13-3/8" O. D. casing cemented with
675	890	Red bed	600 sacks cement at 670'
890	1005	Lime & shale	
1005	1205	Salt & shale	
1205	1216	Shale	
1216	1229	Lime & pyrite	
1229	1261	Lime & shale streaks	
1261	1435	Shale & anhydrite shells	
1435	1755	Shale & anhydrite	8-5/8" O. D. casing cemented at 1653'
1755	2005	Sand & shale	
2005	2028	Lime & shale	
2028	2855	Lime	
2855	3085	Lime & shale	
3085	3165	Lime	
3165	3170	Lime & shale	
3170	3185	Sand	
3185	3453	Lime & shale	
3453	3567	Shale & lime	
3567	3847	Lime & shale	
3847	4230	Shale	
4230	4278	Sand & shale	
4278	4281	Shale	
4281	4383	Lime & shale	
4383	4797	Lime	
4797	4901	Lime & shale	
4901	4976	Lime	
4976	5070	Shale & lime	
5070	5223	Lime & shale	
5223	5283	Lime	
5283	5466	Lime & shale	
5466	5473	Sand & shale	
5473	5604	Lime	Well plugged

RECEIVED
 STATE CORPORATION COMMISSION

FEB 15 1957

CONSERVATION DIVISION
 Wichita, Kansas

T.D. 5604'

This is a true copy of the driller's log as shown on the drilling tickets.

PLUGGING
 FILE SEC. 24 T. 34 R. 21W
 BOOK PAGE 139 LINE 36.

BARBOUR DRILLING COMPANY

By: *[Signature]*

Subscribed and sworn to before me on this 12th day of February, 1957.

Merry Jane Burt
 Notary Public

My commission expires: July 27, 1957