

STATE OF KANSAS
STATE CORPORATION COMMISSION

WELL PLUGGING RECORD


Give All Information Completely
Make Required Affidavit

Mail or Deliver Report to:
Conservation Division
State Corporation Commission
800 Bifling Building
Wichita, Kansas

OR
FORMATION PLUGGING RECORD

Strike out upper line
when reporting plug-
ging off formations.

NORTH

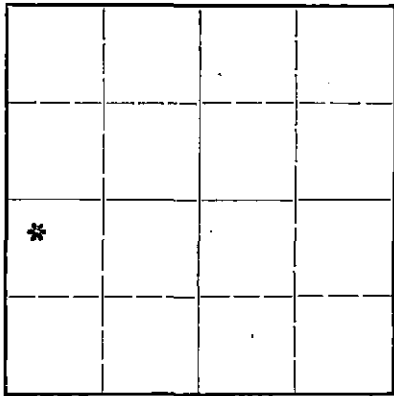

Locate well correctly on above
Section Plat

Pratt County. Sec. **34** Twp. **28** Rge. **X 12 (W)**
Location as "NE 1/4 NW 1/4 SW 1/4" or footage from lines **NW, NW, SW.**
Lease Owner **Mid-Continent Petroleum Corporation**
Lease Name **H. M. Eubank** Well No. **1**
Office Address **Box 1362, Wichita, 1, Kansas.**
Character of Well (completed as Oil, Gas or Dry Hole) **Dry Hole**
Date well completed **Aug. 11th** 19**45**
Application for plugging filed **Aug. 13th** 19**45**
Application for plugging approved **19**
Plugging commenced **Sept. 2nd** 19**45**
Plugging completed **Sept. 7th** 19**45**
Reason for abandonment of well or producing formation **Dry Hole**

If a producing well is abandoned, date of last production **19**
Was permission obtained from the Conservation Division or its agents before plugging was com-
menced? **Yes**

Name of Conservation Agent who supervised plugging of this well **H. W. Kerry, Great Bend, Kansas.**
Producing formation **Oil, Gas or Water** Depth to top **4646** Feet
Bottom **4646** Total Depth of Well **4646** Feet
Show depth and thickness of all water, oil and gas formations.

OIL, GAS OR WATER RECORDS

CASING RECORD

Formation	Content	From	To	Size	Put In	Pulled Out
Kansas City Lime	Water	3799	4144	10 3/4"	416	None
Viola Lime	"	4384	4483	5 1/2"	4529	2183
Simpson Sand	"	4483	4505			
Arbuckle Dolomite	"	4592	4646			

Describe in detail the manner in which the well was plugged, indicating where the mud fluid was placed and the method or methods used in introducing it into the hold. If cement or other plugs were used, state the character of same and depth placed, from _____ feet to _____ feet for each plug set.

7" Casing set at 4531'
Bottom j't. full of cement not drilled out 4497' to 4531'
Perforated 4484' to 4487 1/2'
Set Lane-Wells plug at 4420'
Cemented w/dump bailer 4411' to 4420'
Perforated 4382' to 4389'
Set Lane-Wells plug at 3950'
Cemented 3939' to 3950'
Perforated 3911' to 3915'
Cemented w/dump bailer (10 sacks) 3890' to 3939'
Mudded hole by hand 250' to 3890'
Set rock bridge 250'
Cemented w/dump ba iler (15 sacks) 225' to 250'
Mudded hole 21' to 225'
Cemented (10 sacks) 6' to 21'
Will fill cellar to ground level.

PLUGGING
FILE **34-28-12-1**
BOOK PAGE **26** LINE **22**

(If additional description is necessary, use BACK of this sheet)

Correspondence regarding this well should be addressed to **Mr Lloyd Snyder**
Address **Box 1362, Wichita, 1, Kansas.**

STATE OF **Kansas**, COUNTY OF **Barton**, ss.
S. K. McLanahan (employee of owner) or ~~XXXXXXXXXX~~ of the above-described well,

being first duly sworn on oath, says: That I have knowledge of the facts, statements, and matters herein contained and the log of the above-described well as filed and that the same are true and correct. So help me God.


(Signature) **S. K. McLanahan**

RR #1, Ellinwood, Kansas.
(Address)

SUBSCRIBED AND SWORN to before me this **7th** day of **Sept.,** 19**45**

My commission expires **July 7 - 1948**

approved
Reoyd Snyder
9-8-45
09-10-45

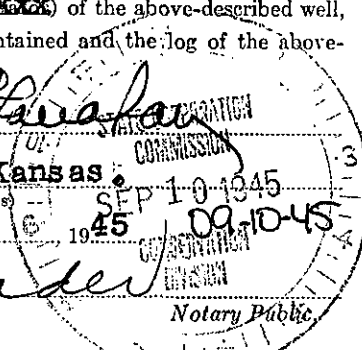

COMPANY - Mid-Continent Petroleum Corp.
FARM - H. M. Eubank No. 1

Sec. 34 T. 28S R. 12W
NW SW

Total Depth 4646'

Comm. 7-6-45

Comp. 8-11-45

COUNTY - Pratt

Shot or treated.

Casing perforated in Simpson Sand, Viola Lime
and Kansas City Lime

Contractor - Barnett Drilling Co.

Elevation 1902

CASING:

10 3/4"	32 3/4#	New S.S.	415'5"
5 1/2"	15 1/2#	New S.S.	4528'9"

Production Dry

Surface Clay	0	60
Shale	60	75
Sand	75	260
Lime & shale	260	428
Red bed	428	1050
Blue shale & shells	1050	1730
Lime	1730	2190
Broken lime & shale	2190	2220
Lime	2220	2300
Shale	2300	2320
Lime	2320	2545
Lime & shale	2545	2755
Lime	2755	2790
Shale	2790	2820
Lime & shale	2820	2925
Lime	2925	3100
Sand	3100	3130
Lime	3130	3380
Sandy lime	3380	3500
Lime	3500	3799
K. C. Lime	3799	4144
Lime & shale	4144	4201
Lime	4201	4236
Chert	4236	4273
Lime	4273	4316
Shale	4316	4384
Viola lime	4384	4483
Simpson sand	4483	4505
Simpson shale	4505	4541
Sandy lime	4541	4549
Lime & shale	4549	4592
Arbuckle Dolomite	4592	4646
TOTAL DEPTH		

Tops:

K. C. Lime	3799
Mississippi lime	4236
Kinderhook	4316
Viola lime	4384
Simpson sand	4483

