

STATE OF KANSAS
STATE CORPORATION COMMISSION

Form CP-4


Give All Information Completely
Make Required Affidavit
Mail or Deliver Report to:
Conservation Division
State Corporation Commission
212 No. Market
Wichita, Kansas

WELL PLUGGING RECORD

Pratt County. Sec. 34 Twp. 28 Rge. 12 (E) (X) (W) West

Location as "NE/CNW/SW" or footage from lines: C NE/4 SE4
Lease Owner Icer Addis
Lease Name KRANKENBERG Well No. 1
Office Address Box 519 - Great Bend, Kansas
Character of Well (completed as Oil, Gas or Dry Hole) Dry Hole
Date well completed Dec. 12 19 70
Application for plugging filed Dec. 12 19 70
Application for plugging approved Dec. 12 19 70
Plugging commenced Dec. 12 19 70
Plugging completed Dec. 12 19 70

Reason for abandonment of well or producing formation _____
If a producing well is abandoned, date of last production _____ 19 ____
Was permission obtained from the Conservation Division or its agents before plugging was commenced? Yes

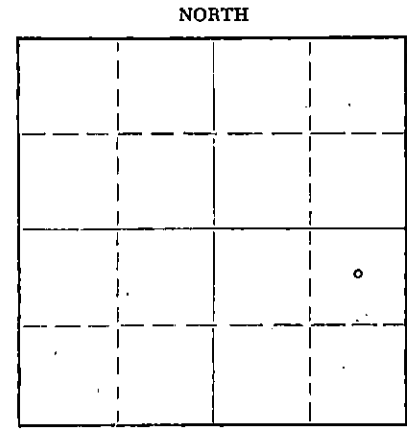

Locate well correctly on above Section Plat

Name of Conservation Agent who supervised plugging of this well Russ Biberstein
Producing formation _____ Depth to top _____ Bottom _____ Total Depth of Well 4525 Feet
Show depth and thickness of all water, oil and gas formations.

OIL, GAS OR WATER RECORDS

CASING RECORD

| FORMATION | CONTENT | FROM | TO | SIZE | PUT IN | PULLED OUT |
|-----------|---------|------|----|------|--------|------------|
| | | | | | | |
| | | | | | | |
| | | | | | | |
| | | | | | | |
| | | | | | | |
| | | | | | | |
| | | | | | | |

Describe in detail the manner in which the well was plugged, indicating where the mud fluid was placed and the method or methods used in introducing it into the hole. If cement or other plugs were used, state the character of same and depth placed, from _____ feet to _____ feet for each plug set.

Hole full of heavy mud to 600' - set plug & 40 sks. cement
Come up hole to 350' - Plug 25 sks. cement
Come up hole to 40' - 1/2 sk. hulls, plug & 10 sks. cement.
2 sacks cement in rat hole

RECEIVED
STATE CORPORATION COMMISSION
DEC 15 1970
CONSERVATION DIVISION
Wichita, Kansas

(If additional description is necessary, use BACK of this sheet)
Name of Plugging Contractor _____
Address _____

STATE OF Kansas, COUNTY OF Barton, ss.
Larry Curtis (employee of owner) or ~~owner~~ of the above-described well, being first duly sworn on oath, says: That I have knowledge of the facts, statements, and matters herein contained and the log of the above-described well as filed and that the same are true and correct. So help me God.

(Signature) Larry Curtis
Box 823-Great Bend, Kansas 67530
(Address)

SUBSCRIBED AND SWORN to before me this 14th day of December, 1970
Marathy M. Hogue
Notary Public.

My commission expires 4-11-74

W E L L L O G

DATE COMMENCED: November 30, 1970
 DATE COMPLETED: December 12, 1970

Loc: Addis
 KRANKENBERG #1
 C NE SE
 Sec. 34-T28S-R12W
 Pratt County, Kansas

ELEVATION: 1899 K.B.

0 - 65' Clay
 65 - 145' Sand & Clay
 145 - 210' Sand - Shale
 210 - 694' Red Bed
 694 - 730' Anhydrite
 730 - 1000' Red Bed
 1000 - 1650' Shale
 1650 - 2030' Shale & Lime
 2030 - 3407' Lime & Shale
 3407 - 3591' Lime
 3591 - 3595' Shale
 3595 - 3622' Lime - Shale
 3622 - 3778' Shale
 3778 - 3790' Lime & Shale
 3790 - 4144' Lime
 4144 - 4232' Shale & Lime
 4232 - 4330' Lime
 4330 - 4413' Shale
 4413 - 4517' Chert
 4519 - 4525' Sand
 4525' RTD

FORMATION DATA

ANHYDRITE 694
 HEEBNER 3591
 TORONTO 3610
 DOUGLAS 3622
 BROWN LIME 3778
 LANSING 3790
 BASE LANSING 4144
 MISSISSIPPI 4232
 KINDERHOOK 4330
 VIOLA 4413
 SIMPSON 4517
 RTD 4525

RECEIVED
 STATE CORPORATION COMMISSION
 DEC 15 1970
 CONSERVATION DIVISION
 Wichita, Kansas

SURFACE PIPE: Set new 20#
 8-5/8" casing at 394' with
 255 sacks cement.

A F F I D A V I T

STATE OF KANSAS
 COUNTY OF BARTON) ss.

Larry Curtis, of lawful age, does swear and state that the facts and statements herein contained are true and correct to the best of his knowledge.

Larry Curtis

Subscribed and sworn to before me this 14 day of December 1970

My Comm. Expires:
April 11, 1974

Deborah M. Sagner
 Notary Public