

STATE OF KANSAS
STATE CORPORATION COMMISSION

WELL PLUGGING RECORD

Give All Information Completely
Make Required Affidavit
Mail or Deliver Report to
Conservation Division
State Corporation Comm.
245 North Water
Wichita, KS 67202

Pratt County. Sec. 34 Twp. 28S Rge. 12W E/W
Location as "NE/CNW $\frac{1}{4}$ SW $\frac{1}{4}$ " or footage from lines
NW SE NW


Lease Owner Carnes & Dunne Exploration, Inc.
Lease Name Lawton (Old Well) Well No. #1 Wash Down
Office Address 105 S. Broadway, Suite 740, Wichita, KS
Character of Well (Completed as Oil, Gas or Dry Hole)
Dry Hole

Date Well completed 11/12/81 19
Application for plugging filed 11/12/81 19
Application for plugging approved 11/12/81 19
Plugging commenced 11/11/81 19
Plugging completed 11/12/81 @ 1:30 a.m. 19

Reason for abandonment of well or producing formation
D & A
If a producing well is abandoned, date of last production
none 19

Was permission obtained from the Conservation Division or
its agents before plugging was commenced? yes

Name of Conservation Agent who supervised plugging of this well Maurice Leslie
Producing formation X Depth to top X Bottom X Total Depth of Well 4510'
Show depth and thickness of all water, oil and gas formations.

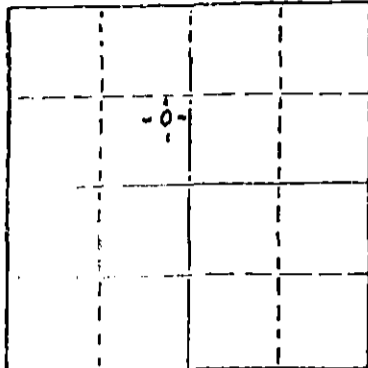

Locate well correctly on above
Section Plat

OIL, GAS OR WATER RECORDS

CASING RECORD

FORMATION	CONTENT	FROM	TO	SIZE	PUT IN	PULLED OUT

Describe in detail the manner in which the well was plugged, indicating where the mud fluid
was placed and the method or methods used in introducing it into the hold. If cement or other
plugs were used, state the character of same and depth placed, from _____ feet to
_____ feet for each plug set.

Run 60 sacks at 620'
50 sacks at 360'
10 sacks at 40' Bridge
10 sacks Rat Hole
5 sacks Mouse Hole
2 sacks in Water Well.

(If additional description is necessary, use BACK of this sheet)


Name of Plugging Contractor State Corporation Commission of Kansas

STATE OF KANSAS COUNTY OF SEDGWICK, ss.
Ray Williams (employee of owner) or (owner or operator)
of the above-described well, being first duly sworn on oath, says: That I have knowledge of
the facts, statements, and matters herein contained and the log of the above-described well
is filed and that the same are true and correct. So help me God.

(Signature) Ray Williams
RAY WILLIAMS

(Address)

SUBSCRIBED AND SWORN TO before me this 12th day of November, 19 81

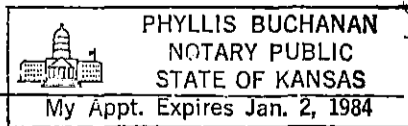

Phyllis Buchanan
Notary Public.
RECEIVED
STATE CORPORATION COMMISSION

My commission expires

DEC 16 1981
12-16-81
CONSERVATION DIVISION
Wichita Kansas