


15-119-10247-0000

STATE OF KANSAS
STATE CORPORATION COMMISSION

Give All Information Completely
Make Required Affidavit
Mail or Deliver Report to:
Conservation Division
State Corporation Commission
211 No. Broadway
Wichita, Kansas

WELL PLUGGING RECORD

Meade County, Sec. 11 Twp. 34S Rge. (1/2) 27 (W)
Location as "NE/CNW/SW" or footage from lines 100' W of C SE/4
Lease Owner Graham-Michaelis Drilling Company
Lease Name Thiessen Well No. 1-11
Office Address 211 North Broadway, Wichita 2, Kansas
Character of Well (completed as Oil, Gas or Dry Hole) Dry Hole
Date well completed Sept. 25, 19 61
Application for plugging filed Sept. 26, 19 61
Application for plugging approved (verbal) Sept. 25, 19 61
Plugging commenced Sept. 25, 19 61
Plugging completed Sept. 25, 19 61
Reason for abandonment of well or producing formation DRY HOLE

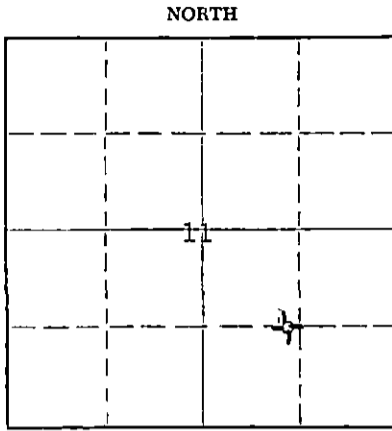

Locate well correctly on above Section Plat

If a producing well is abandoned, date of last production none 19 --
Was permission obtained from the Conservation Division or its agents before plugging was commenced? yes

Name of Conservation Agent who supervised plugging of this well Fred W. Hampel, Pretty Prairie, Kansas
Producing formation none Depth to top --- Bottom --- Total Depth of Well 6140 Feet
Show depth and thickness of all water, oil and gas formations.

OIL, GAS OR WATER RECORDS

CASING RECORD

FORMATION	CONTENT	FROM	TO	SIZE	PUT IN	PULLED OUT
				8 5/8	1370'	none

Describe in detail the manner in which the well was plugged, indicating where the mud fluid was placed and the method or methods used in introducing it into the hole. If cement or other plugs were used, state the character of same and depth placed, from feet to feet for each plug set.

Filled hole with heavy mud to 1325', set plug with 20 sax cement. Filled hole to 600' with mud. Set plug with 20 sax cement. Filled hole with heavy mud to 45', then with 20 sax cement on top.

RECEIVED
STATE CORPORATION COMMISSION
SEP 29 1961
9-29-61
CONSERVATION DIVISION
WICHITA, KANSAS

(If additional description is necessary, use BACK of this sheet)

Name of Plugging Contractor Graham-Michaelis Drilling Company
Address 211 North Broadway, Wichita 2, Kansas

STATE OF Kansas, COUNTY OF Sedgwick, ss.
John L. James (employee of owner) of the above-described well, being first duly sworn on oath, says: That I have knowledge of the facts, statements, and matters herein contained and the log of the above-described well as filed and that the same are true and correct. So help me God.

(Signature) John L. James
211 North Broadway, Wichita 2, Kansas
(Address)

SUBSCRIBED AND SWORN TO before me this 26 day of September, 19 61

V.D. Grier
Notary Public.

My commission expires January 7, 1965



