

15-119-10256-0000

STATE OF KANSAS
STATE CORPORATION COMMISSION

Form CP-4


Give All Information Completely
Make Required Affidavit
Mail or Deliver Report to:
Conservation Division
State Corporation Commission
212 No. Market
Wichita, Kansas

WELL PLUGGING RECORD

Meade County, Sec. 9 Twp. 34 Rge. 27 (E) W (W)

Location as "NE/CNW/SW" or footage from lines C/SE/NE
Lease Owner Horizon Oil & Gas Co.
Lease Name Merkle Well No. 1-9
Office Address P. O. Box 7, Spearman, Texas 79081
Character of Well (completed as Oil, Gas or Dry Hole) Gas
Date well completed 9-16-64 19
Application for plugging filed Verbal 11-7-84 19
Application for plugging approved Verbal 11-7-84 19
Plugging commenced 12-7-84 19
Plugging completed 12-7-84 19
Reason for abandonment of well or producing formation Uneconomical

NORTH

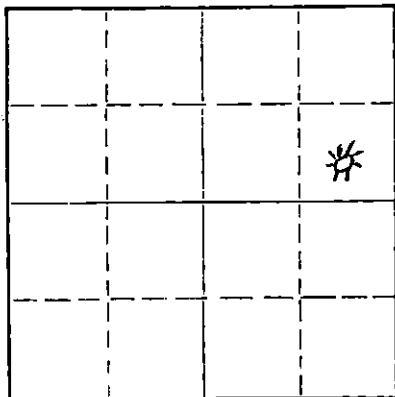

Locate well correctly on above
Section Plat

If a producing well is abandoned, date of last production September, 1981 19
Was permission obtained from the Conservation Division or its agents before plugging was commenced? Yes

Name of Conservation Agent who supervised plugging of this well Paul Luthi
Producing formation Mississippian Depth to top 5943 Bottom 5975 Total Depth of Well 6030 Feet
Show depth and thickness of all water, oil and gas formations.

OIL, GAS OR WATER RECORDS

CASING RECORD

FORMATION	CONTENT	FROM	TO	SIZE	PUT IN	PULLED OUT
Mississippian	Gas	5943	5975	2 7/8"	6030	2338

Describe in detail the manner in which the well was plugged, indicating where the mud fluid was placed and the method or methods used in introducing it into the hole. If cement or other plugs were used, state the character of same and depth placed, from _____ feet to _____ feet for each plug set.
Set CIBP at 5893' - Cut off 2 7/8" casing at 2338'/
35 sacks of class "H" at 2306' - 40 sacks of class "H" at 1400' - 30 sacks of class "H" at 660' - 10 sacks of class "H" from 0 to 40'.
Cutt off 8-5/8" and Welded on Plate

STATE CORPORATION COMMISSION

DEC 17 1984

CONSERVATION DIVISION
Wichita, Kansas

(If additional description is necessary, use BACK of this sheet)

Name of Plugging Contractor The Western Company
Address Perryton, Texas 79070

STATE OF Texas, COUNTY OF Hansford, ss.
Curtis Covington (employee of owner) or (owner or operator) of the above-described well, being first duly sworn on oath, says: That I have knowledge of the facts, statements, and matters herein contained and the log of the above-described well as filed and that the same are true and correct. So help me God.

(Signature) [Signature]

P. O. Box 7, Spearman, Texas 79081
(Address)

SUBSCRIBED AND SWORN TO before me this 12th day of December, 19 84

My commission expires 5-31-85

Notary Public.