

15-119-10284-0000

STATE OF KANSAS
STATE CORPORATION COMMISSION

WELL PLUGGING RECORD

Give All Information Completely
Make Required Affidavit
Mail or Deliver Report to:
Conservation Division
State Corporation Commission
800 Bitting Building
Wichita, Kansas

MEADE County. Sec. 10 Twp. 34S Rge. 26W (E) (W)

Location as "NE/CNW%SW%" or footage from lines SW¹/₄ SW¹/₄ NE¹/₄

Lease Owner ROD OIL COMPANY

Lease Name DAVID J. WILSON Well No. 1

Office Address 314 South Harwood, Dallas, Texas

Character of Well (completed as Oil, Gas or Dry Hole) Dry Hole

Date well completed 9-30-52 19

Application for plugging filed 9-30-52 19

Application for plugging approved 9-30-52 19


Plugging commenced 10-1-52 19

Plugging completed 10-1-52 19

Reason for abandonment of well or producing formation no shows of oil or gas in commercial quantities were found

If a producing well is abandoned, date of last production ----- 19

Was permission obtained from the Conservation Division or its agents before plugging was commenced? yes

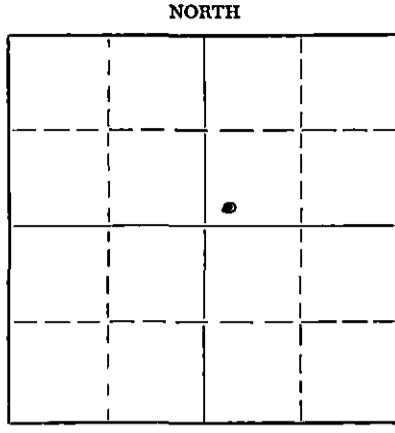

Locate well correctly on above Section Plat

Name of Conservation Agent who supervised plugging of this well Mr. M. A. Rives, 148 Pratt, Kansas

Producing formation none Depth to top - Bottom - Total Depth of Well 5882 Feet

Show depth and thickness of all water, oil and gas formations.

OIL, GAS OR WATER RECORDS

CASING RECORD

FORMATION	CONTENT	FROM	TO	SIZE	PUT IN	PULLED OUT
None				10-3/4	1504'	NONE

Describe in detail the manner in which the well was plugged, indicating where the mud fluid was placed and the method or methods used in introducing it into the hole. If cement or other plugs were used, state the character of same and depth placed, from _____ feet to _____ feet for each plug set.

Mud laden fluid was put in hole through the drill pipe from the bottom to a point 300' from the top. At this point a Halliburton plug was placed on top of Cottenseed hulls and cemented with 25 sacks. At a point 35' down from the top of the hole another Halliburton plug was set on top of cottenseed hulls and cemented with 10 sacks.

RECEIVED
STATE CORPORATION COMMISSION

(If additional description is necessary, use BACK of this sheet)
Name of Plugging Contractor Nichols Duncan Drilling Company
Address Duncan, Oklahoma
OCT 14 1952
10-14-52
CONSERVATION DIVISION
Wichita, Kansas

STATE OF Texas, COUNTY OF Dallas, ss.
E. H. Rowley - owner (employee of owner) or (owner or operator) of the above-described well, being first duly sworn on oath, says: That I have knowledge of the facts, statements, and matters herein contained and the log of the above-described well as filed and that the same are true and correct. So help me God.

(Signature) E. H. Rowley
314 South Harwood, Dallas, Texas (Address)

SUBSCRIBED AND SWORN TO before me this 7th day of October, 1952
Mildred Freeman
MILDRED FREEMAN
Notary Public.

My commission expires June 1 - 1953

PLUGGING
FILE SEC 10 T 34 R 26
BOOK PAGE 48 LINE 16