

STATE OF KANSAS
STATE CORPORATION COMMISSION

Form CP-4

Give All Information Completely
Make Required Affidavit
Mail or Deliver Report to:
Conservation Division
State Corporation Commission
212 No. Market
Wichita, Kansas

WELL PLUGGING RECORD

Meade County, Sec. 5 Twp. 34 Rge. 27 (E) W (W)

Location as "NE/CNW/SW" or footage from lines C S/2 NE/4
Lease Owner Horizon Oil & Gas Co.

Lease Name D. Davis "B" Well No. 1-5

Office Address P. O. Box 7, Spearman, Texas 79081

Character of Well (completed as Oil, Gas or Dry Hole) Gas

Date well completed 1-10-65 19 65

Application for plugging filed Verbal 11-7-84 19 84

Application for plugging approved Verbal 11-7-84 19 84


Plugging commenced 12-4-84 19 84

Plugging completed 12-4-84 19 84

Reason for abandonment of well or producing formation Uneconomical

If a producing well is abandoned, date of last production August, 1981 19 81

Was permission obtained from the Conservation Division or its agents before plugging was commenced? Yes

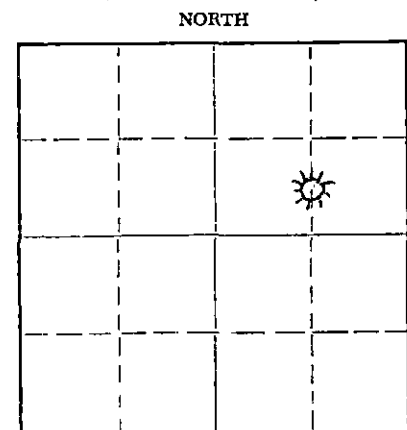

Locate well correctly on above Section Plat

Name of Conservation Agent who supervised plugging of this well Paul Luthi

Producing formation Mississippian Depth to top 5910' Bottom 5991' Total Depth of Well 6025' Feet

Show depth and thickness of all water, oil and gas formations.

OIL, GAS OR WATER RECORDS

CASING RECORD

FORMATION	CONTENT	FROM	TO	SIZE	PUT IN	PULLED OUT
Mississippian	Gas	5910'	5991'	2 7/8"	6025'	2290'

Describe in detail the manner in which the well was plugged, indicating where the mud fluid was placed and the method or methods used in introducing it into the hole. If cement or other plugs were used, state the character of same and depth placed, from feet to feet for each plug set.

Set CIBP at 5860' - 1 sack class "H" cement on top of CIBP.
Cut off 2 7/8" casing at 2290' - 35 sacks class "H" at 2260' - 40 sacks class "H" at 1430' - 30 sacks of class "H" at 660' - 10 sacks of class "H" from 0 to 40'.
Cut off 8-5/8" and welded plate on

STATE CORPORATION COMMISSION

DEC 17 1984

CONSERVATION DIVISION
WICHITA, KANSAS

(If additional description is necessary, use BACK of this sheet)

Name of Plugging Contractor The Western Company
Address Perryton, Texas 79070

STATE OF Texas, COUNTY OF Hansford, ss.

Curtis Covington (employee of owner) or (owner or operator) of the above-described well, being first duly sworn on oath, says: That I have knowledge of the facts, statements, and matters herein contained and the log of the above-described well as filed and that the same are true and correct. So help me God.

(Signature) Curtis F. Covington

P. O. Box 7, Spearman, Texas 79081 (Address)

SUBSCRIBED AND SWORN TO before me this 12th day of December, 19 84

[Signature] Notary Public.

My commission expires 5-31-85